IREDELL COUNTY HEALTH DEPARTMENT

Const. Auth. STATESVILLE 704-878-5305 MOORESVILLE 704-664-5281

IMPROVEMENT PERMIT / ~~CERTIFICATE OF COMPLETION~~ / OPERATION PERMIT / EXISTING SYSTEM INSPECTION

PROPERTY DESCRIPTION NO. 24652 DATE Sept. 10, '97 TAX MAP NO. part of ILA5 4658 21 2918 Watershed: ☒ Yes ☐ No

OWNER OR CONTRACTOR Lyon Financial Services PHONE: Business _____ Home _____

ADDRESS 149 Yacht Cove Rd, Mooresville

LOCATION 121 N. TL Valleyview TR Brooktree on left

SUBDIVISION Oakbrook BLOCK / SECTION _____ LOT 73 LOT AREA 4.38ac SITE CLASS. PS DESIGN FLOW 360gpd L.T.A.R. .3

Septic Tank: 1000 Gallons; STB 825 Date 11/7/98

Pump Tank: 1000 Gallons; PT 47 Date _____

Pump Make: _____ Model _____ Serial No. _____

Nitrification Field: No Fields 1 Square Feet 1200 Linear Feet 400

No Lines 3@133' Trench Width 36" Max Trench Bottom Depth 18-24" Gravel Depth 12"

☒ New System ☐ Repair System Type: I, II, ☒ III, IV, V, VI

System Description: pumped-pm-conventional

Repair System Description: Same

Maintenance Agreement Required: ☐ Yes ☒ No

☒ House/Mod. Home No. Bedrooms 3

☐ Mobile Home No. Bathrooms 2

☐ Business No. Employees _____

☐ Other _____

☒ Slab ☒ Crawl Space ☐ Basement w/plumbing ☐ Basement wo/plumbing


Water Supply: ☒ Individual ☐ Community ☐ Public

Comments:


Comments: ALARM -

1" = 100'

INITIAL SITE SKETCH

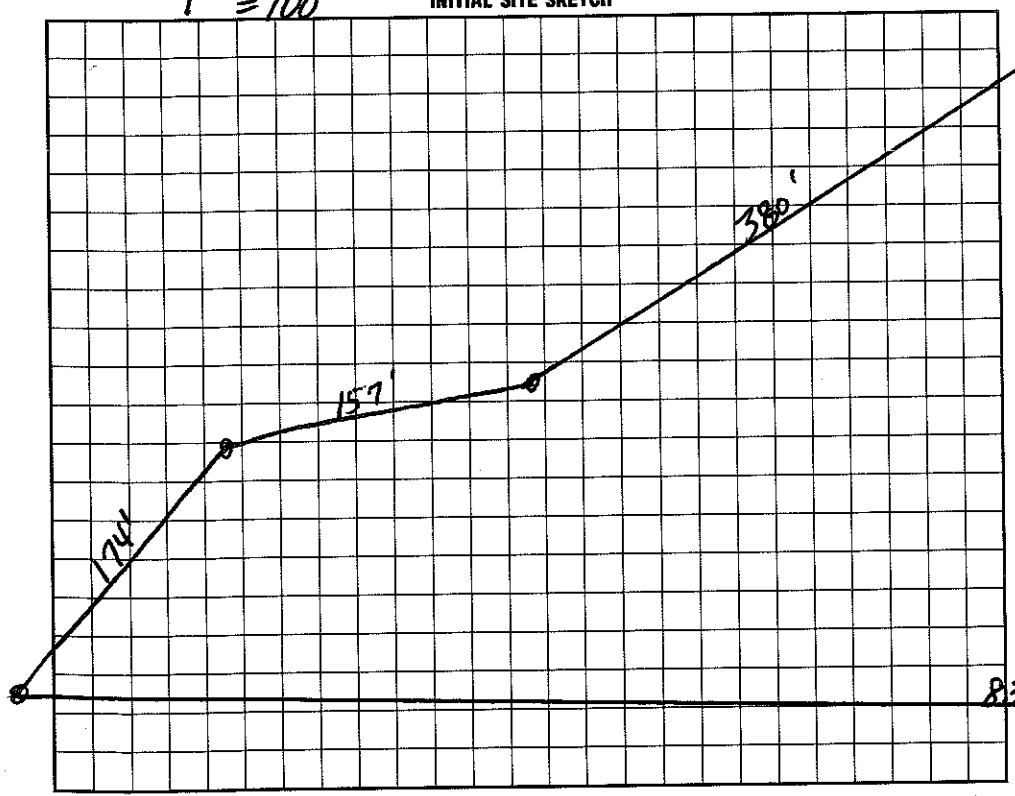

AS BUILT SKETCH

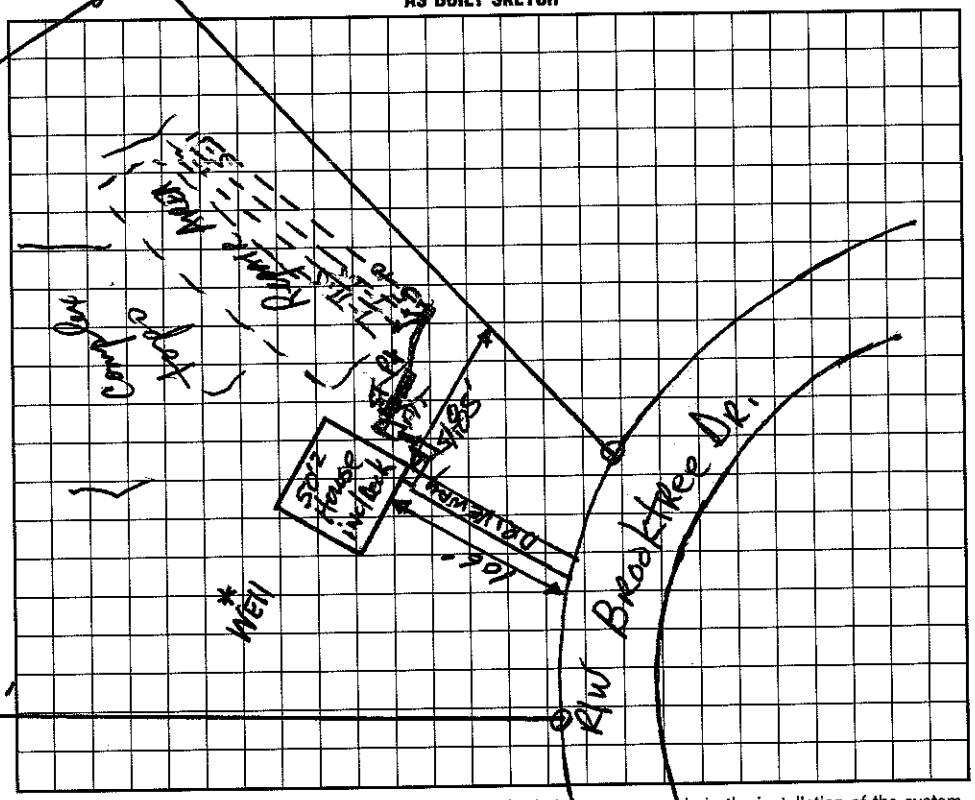

I understand that this permit can be suspended or revoked if any false information is supplied toward securing the permit/any unauthorized changes are made to the site/any unauthorized changes are made in the installation of the system. Improvement Permit is valid for 60 months from date of issuance.

Signed: [signature]

Improvement Permit by: [signature] RS date 9-10-97

~~Construction Authorization by:~~ [signature] RS date 9-10-97

Installed by: Rowan Septic Tank

Certificate of Completion by: Wesley Sparks RS. date 6/16/98

Operation Permit by: Wesley Sparks RS. date 6/16/98

WHITE: HEALTH DEPT. COPY; GREEN: INSPECTION COPY (FINAL); YELLOW: OWNER COPY (FINAL); PINK: INSPECTION COPY (INITIAL); GOLD: OWNER COPY (INITIAL)