IREDELL COUNTY HEALTH DEPARTMENT

Const. Auth. STATESVILLE 704-878-5305 MOORESVILLE 704-664-5281 (3:30 - 4:00)

IMPROVEMENT PERMIT / ~~CERTIFICATE OF COMPLETION~~ / OPERATION PERMIT / EXISTING SYSTEM INSPECTION

PROPERTY DESCRIPTION NO. 2469 DATE Oct. 14, '97 TAX MAP NO. part of 12A5 4658 21 3296 Watershed: ☑ Yes ☐ No

OWNER OR CONTRACTOR Kyom Financial Services PHONE: Business 664-3671 Home

ADDRESS 149 Yacht Cove Rd. Mooresville

LOCATION I-21 N. TL Valleyview TR Brooktree on left across from Mayenny Ln.

SUBDIVISION Oakbrook BLOCK / SECTION LOT 70 LOT AREA 1.66 Ac SITE CLASS. PS DESIGN FLOW 360gpd L.T.A.R. ~.3

Septic Tank: 1000 Gallons; STB# ST 825 Date 6-1-98

Pump Tank: 1000 Gallons; PST 1087 Date 7/6/98

Pump Make: Model Serial No.

Nitrification Field: No Fields 1 Square Feet 1200 Linear Feet 400

No Lines 3@133' Trench Width 36" Max Trench Bottom Depth 24" Gravel Depth 12"

☑ New System ☐ Repair System Type: I, II, III, IV, V, VI

System Description: pumped-pressure conventional

Repair System Description: same

Maintenance Agreement Required: ☐ Yes ☑ No

☑ House/Mod. Home No. Bedrooms 3

☐ Mobile Home No. Bathrooms 2

☐ Business No. Employees

☐ Other

☐ Slab ☑ Crawl Space ☐ Basement w/plumbing ☐ Basement wo/plumbing


Water Supply: ☑ Individual ☐ Community ☐ Public

Comments: Tanks & lines checked 8/25/98 MD


Comments: Well installed as shown. Pressure tested 8/25/95 MD

1"=100'

INITIAL SITE SKETCH

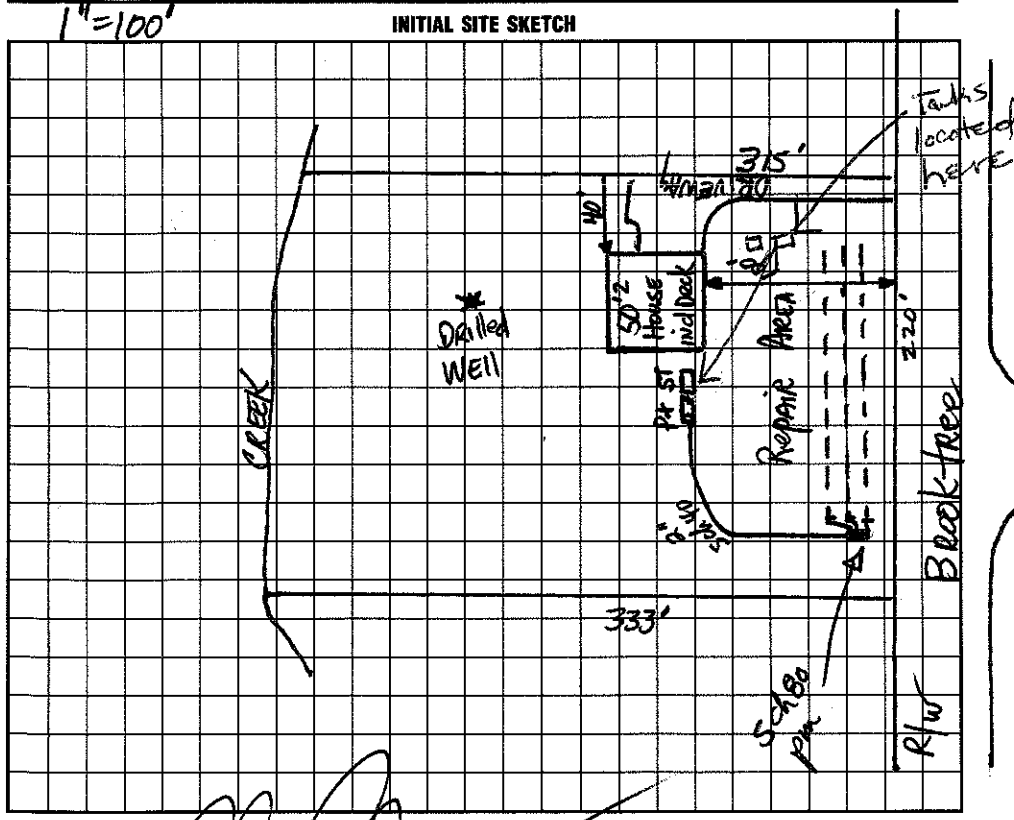

AS BUILT SKETCH

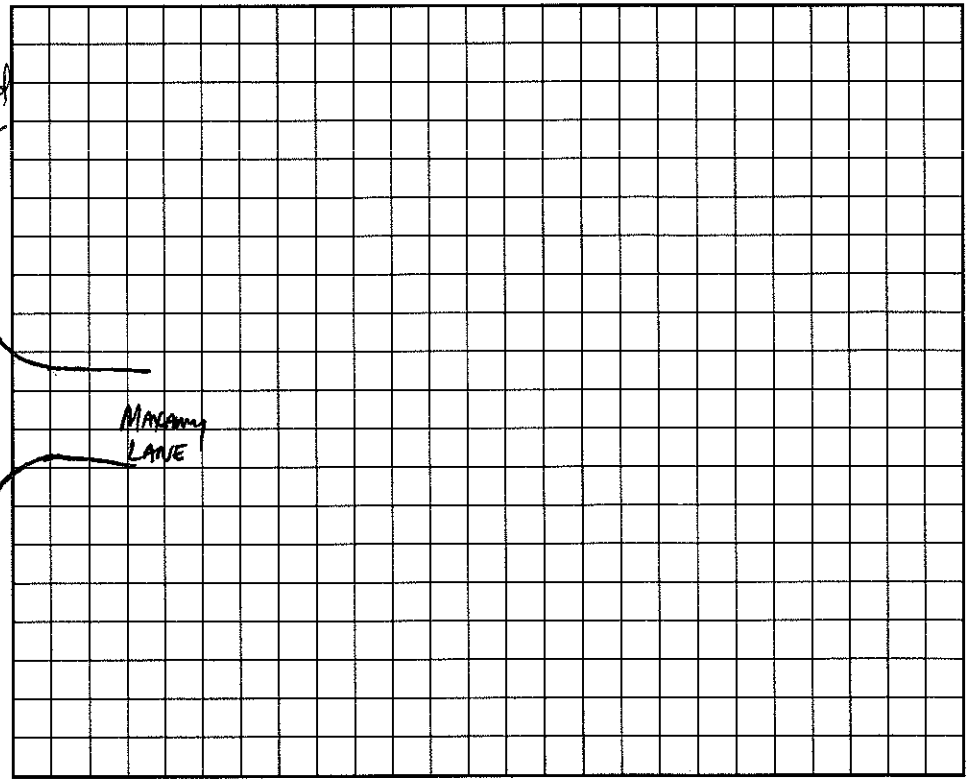

I understand that this permit can be suspended or revoked if any false information is supplied toward securing the permit/any unauthorized changes are made to the site/any unauthorized changes are made in the installation of the system. Improvement Permit is valid for 60 months from date of issuance.

Signed:

Improvement Permit by: RS date 10-14-97

~~Construction~~ ~~Existing System~~ Inspection by: RS date 10-14-97

Authorization

Installed by: ROWAN SEPTIC

Certificate of Completion by: date

Operation Permit by: date 8/27/98

HEALTH DEPT. COPY: WHITE INSPECTION COPY (FINAL): GREEN OWNER COPY (FINAL): YELLOW INSPECTION COPY (INITIAL): PINK OWNER COPY (INITIAL): GOLD