IREDELL COUNTY HEALTH DEPARTMENT

Const. Auth. STATESVILLE 704-878-5305 MOORESVILLE 704-664-5281

IMPROVEMENT PERMIT / ~~CERTIFICATE OF COMPLETION~~ / OPERATION PERMIT / EXISTING SYSTEM INSPECTION

PROPERTY DESCRIPTION NO. 24648 DATE Oct 14, 97 TAX MAP NO. part of 1LA5 4658 21 5007 Watershed: ☑ Yes ☐ No

OWNER OR CONTRACTOR Kuppe Financial Services PHONE: Business 664-3671 Home 455-7CA

ADDRESS 149 Yacht Cove Rd. Mooresville

LOCATION 21 N. TL Valleyview TR Brooktree 2nd lot on left

SUBDIVISION Oakbrook BLOCK / SECTION ____ LOT 69 LOT AREA 1.55 Ac SITE CLASS. PS DESIGN FLOW 360gpd L.T.A.R. n.3

Septic Tank: 1000 Gallons; STB 855 Date 8/17/97

Pump Tank: 1000 Gallons; PT 47 Date 9/8/98

Pump Make: ____ Model ____ Serial No. ____

Nitrification Field: No Fields 1 Square Feet 1200 Linear Feet 400

No Lines 3 @ 133' Trench Width 36" Max Trench Bottom Depth 24" Gravel Depth 12"

☑ New System ☐ Repair System Type: I, II, III, IV, V, VI

System Description: pumped pm - conventional

Repair System Description: same

Maintenance Agreement Required: ☐ Yes ☑ No

☑ House/Mod. Home No. Bedrooms 3

☐ Mobile Home No. Bathrooms 2

☐ Business No. Employees ____

☐ Other ____


☐ Slab ☑ Crawl Space ☐ Basement w/plumbing ☐ Basement wo/plumbing

Water Supply: ☑ Individual ☐ Community ☐ Public

Comments: TANKS & ~~PT~~ PM - CHANGED TO OTHER SIDE OF LOT.

Comments:

INITIAL SITE SKETCH

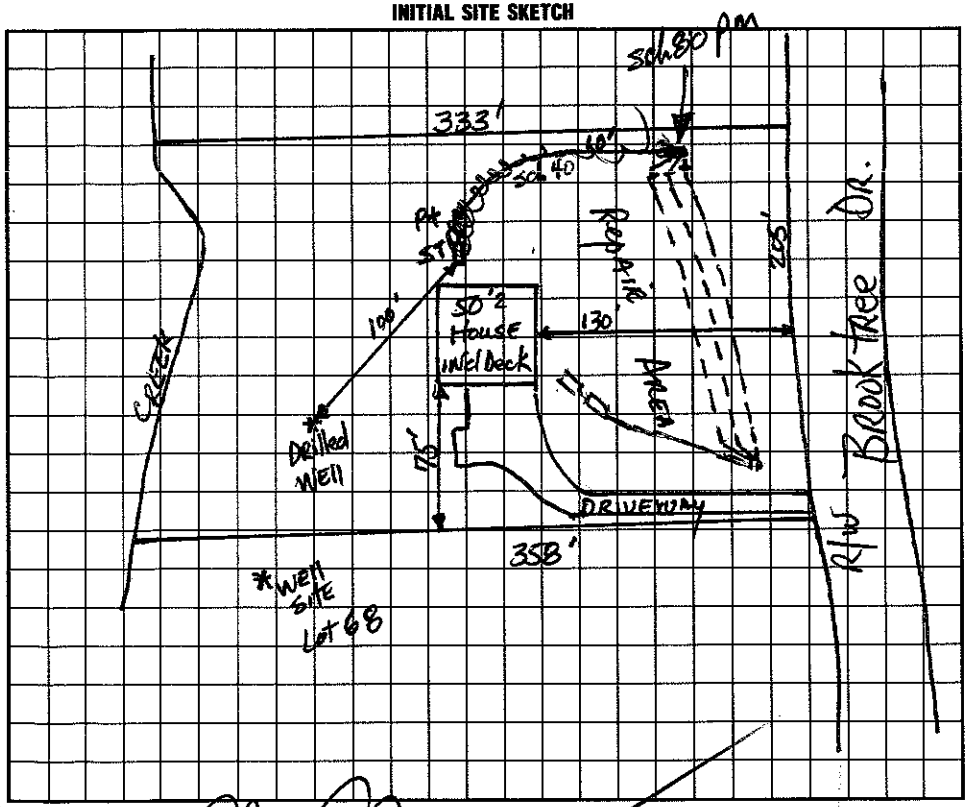

AS BUILT SKETCH

I understand that this permit can be suspended or revoked if any false information is supplied toward securing the permit/any unauthorized changes are made to the site/any unauthorized changes are made in the installation of the system. Improvement Permit is valid for 60 months from date of issuance.

Signed: ____

Improvement Permit by: DR Thomas RS date 10-14-97

~~Existing System Inspection~~ Construction Authorization by: DR Thomas RS date 10-14-97

Installed by: Rowan Septic

Certificate of Completion by: ____ date 11/12/98

Operation Permit by: ____ date ____

HLTH DEPT. COPY: WHITE INSPECTION COPY (FINAL): GREEN OWNER COPY (FINAL): YELLOW INSPECTION COPY (INITIAL): PINK OWNER COPY (INITIAL): GOLD