3:30

IREDELL COUNTY HEALTH DEPARTMENT Const. Auth.

STATESVILLE 704-878-5305 MOORESVILLE 704-664-5281

IMPROVEMENT PERMIT / ~~CERTIFICATE OF COMPLETION~~ / OPERATION PERMIT / EXISTING SYSTEM INSPECTION

PROPERTY DESCRIPTION NO. 24663 DATE June 16, 97 TAX MAP NO. part of 1245 Watershed: ☑ Yes ☐ No

OWNER OR CONTRACTOR Kuon Financial Services PHONE: Business ~~Home~~ 4658-21-7266

ADDRESS 149 Yacht Cove Rd Mooresville

LOCATION 21N TL Valleyview TR Brooktree TR Mayamy 1st lot on Rt. - corner lot

SUBDIVISION Oakbrook BLOCK / SECTION LOT 84 LOT AREA 1.48Ac SITE CLASS. B DESIGN FLOW 360gpd L.T.A.R. .3

Septic Tank: 1000 Gallons; STB 825 Date 5/12/97

Pump Tank: Gallons; PT Date

Pump Make: Model Serial No.

Nitrification Field: No Fields 1 Square Feet 1200 Linear Feet 400

No Lines 3@133' Trench Width 36" Max Trench Bottom Depth 16" Gravel Depth 12"

☑ New System ☐ Repair System Type: I, II, III, IV, V, VI

System Description: Shallow gravity conventional

Repair System Description: Same

Maintenance Agreement Required: ☐ Yes ☐ No

☑ House/Mod. Home No. Bedrooms 3

☐ Mobile Home No. Bathrooms 2

☐ Business No. Employees

☐ Other

☑ Slab ☐ Crawl Space ☐ Basement w/plumbing ☐ Basement wo/plumbing


Water Supply: ☑ Individual ☐ Community ☐ Public

Comments: ST contractor note trench bottom depth.


Comments:

1" = 100'

INITIAL SITE SKETCH

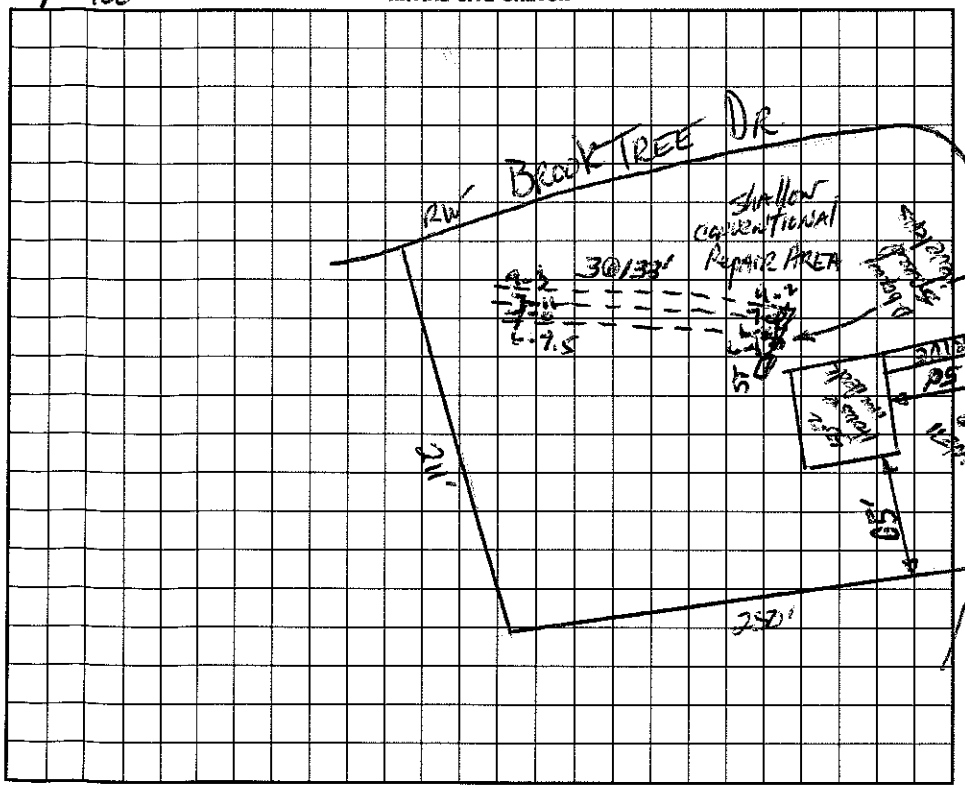

AS BUILT SKETCH

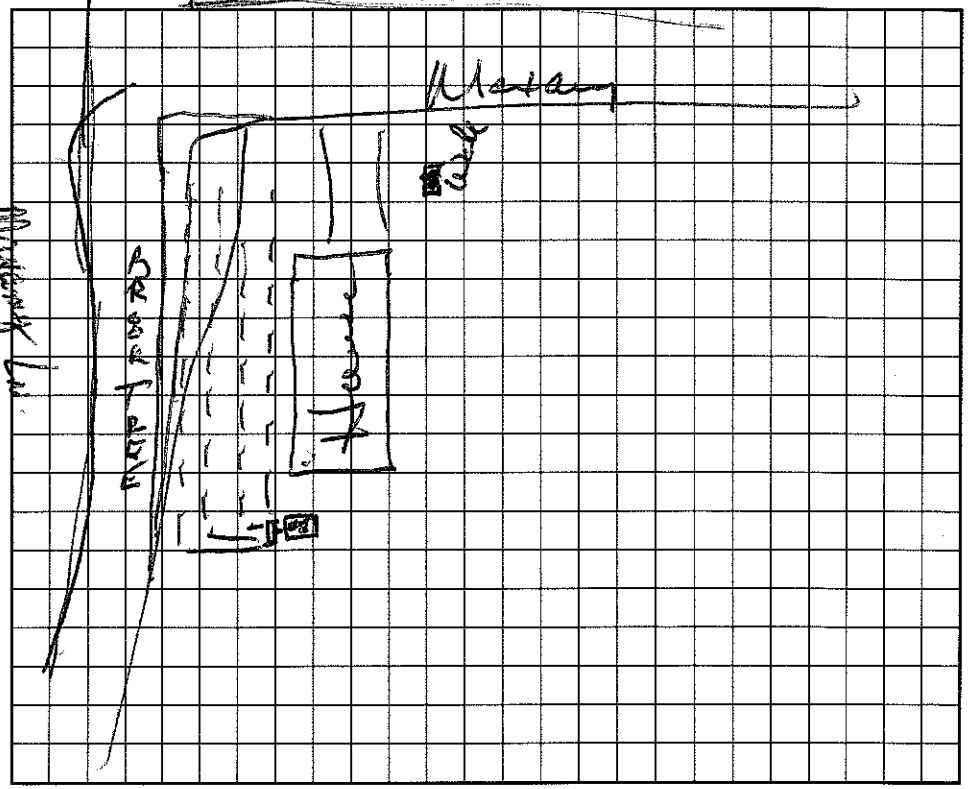

I understand that this permit can be suspended or revoked if any false information is supplied toward securing the permit/any unauthorized changes are made to the site/any unauthorized changes are made in the installation of the system. Improvement Permit is valid for 60 months from date of issuance.

Signed:

Improvement Permit by: DR Inman, RS date 6-16-97

~~Existing System Inspection~~ Construction Authorization by: DR Inman, RS date 6-16-97

Installed by: Rowan Septic Tank

Certificate of Completion by: Wesley Sparks R.S. date 7/29/97

Operation Permit by: Wesley Sparks R.S. date 7/29/97

HEALTH DEPT. COPY: WHITE INSPECTION COPY (FINAL): GREEN OWNER COPY (FINAL): YELLOW INSPECTION COPY (INITIAL): PINK OWNER COPY (INITIAL): GOLD