3:30

IREDELL COUNTY HEALTH DEPARTMENT Const. Auth. STATESVILLE 704-878-5305 MOORESVILLE 704-664-5281

IMPROVEMENT PERMIT / ~~CERTIFICATE OF COMPLETION~~ / OPERATION PERMIT / EXISTING SYSTEM INSPECTION

PROPERTY DESCRIPTION NO. 24658 DATE June 16, '97 TAX MAP NO. pt of 1LA5 Watershed: ☑ Yes ☐ No

OWNER OR CONTRACTOR Kyom Financial Services PHONE: Business ~~Home~~ 4658-21-8687

ADDRESS 1449 Yadkin Ave Ext Mooresville

LOCATION ZIN / TR Valleycrest TR Brooktree TR Maryann 2nd lot on left

SUBDIVISION Oakbrook BLOCK / SECTION LOT 79 LOT AREA 2.87Ac SITE CLASS. FS DESIGN FLOW 360gpd L.T.A.R. .83

Septic Tank: 1000 Gallons; STB 825 Date 8/13/97

Pump Tank: Gallons; PT Date

Pump Make: Model Serial No.

Nitrification Field: No Fields 1 Square Feet 1200 Linear Feet 400

No Lines 3@133' Trench Width 36" Max Trench Bottom Depth 18"

☑ New System ☐ Repair System Type: I, II, III, IV, V, VI

System Description: Shallow gravity conventional system

Repair System Description:

Maintenance Agreement Required: ☐ Yes ☑ No

Gravel Depth 12"

☑ House/Mod. Home No. Bedrooms 3

☐ Mobile Home No. Bathrooms 2

☐ Business No. Employees

☐ Other

☐ Slab ☑ Crawl Space ☐ Basement w/plumbing ☐ Basement wo/plumbing

Water Supply: ☑ Individual ☐ Community ☐ Public

Comments: 386' BROOKTREE DR

Flood plain Area


INITIAL SITE SKETCH

1" = 100'



Comments:

AS BUILT SKETCH

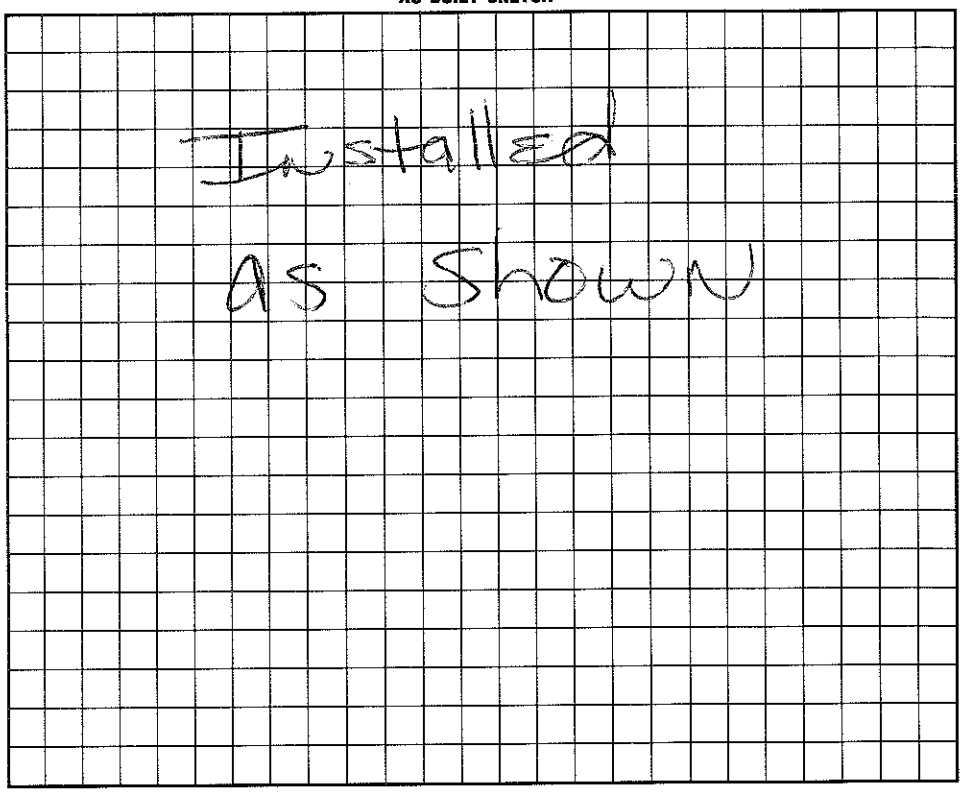

I understand that this permit can be suspended or revoked if any false information is supplied toward securing the permit/any unauthorized changes are made to the site/any unauthorized changes are made in the installation of the system. Improvement Permit is valid for 60 months from date of issuance.

Signed:

Improvement Permit by: date 6/16/97

~~Certificate of Completion~~ Construction Inspection by: date 6/16/97

Installed by: Rowan Septic

Certificate of Completion by: Main H.H. Dotson date 10/1/97

Operation Permit by: Main H.H. Dotson date 10/1/97

HEALTH DEPT. COPY: WHITE INSPECTION COPY (FINAL): GREEN OWNER COPY (FINAL): YELLOW INSPECTION COPY (INITIAL): PINK OWNER COPY (INITIAL): GOLD