IREDELL COUNTY HEALTH DEPARTMENT

STATESVILLE 704-878-5305 MOORESVILLE 704-664-5281

IMPROVEMENT PERMIT / CERTIFICATE OF COMPLETION / OPERATION PERMIT / EXISTING SYSTEM INSPECTION

PROPERTY DESCRIPTION NO. 24653 DATE Sept 10, '97 TAX MAP NO. part of 1LA5 4658 22 6064 Watershed: ☑ Yes ☐ No

OWNER OR CONTRACTOR Raam financial Services PHONE: Business _____ Home _____

ADDRESS 149 Yacht Cove Rd Mooresville

LOCATION 2 LN. TL Valleyview TR Brooktree on left before end

SUBDIVISION Oakbrook BLOCK / SECTION _____ LOT 74 LOT AREA 2.32 Ac SITE CLASS. PS DESIGN FLOW 360gpd L.T.A.R. .3

Septic Tank: 1000 Gallons; STB 885 Date 8/7/98

Pump Tank: 1000 Gallons; PT 47 Date 7/16/98

Pump Make: ZOELLER Model _____ Serial No. _____

Nitrification Field: No Fields 1 Square Feet 1200 Linear Feet 400

No Lines 3@133' Trench Width 36" Max Trench Bottom Depth 24" Gravel Depth 12"

☑ New System ☐ Repair System Type: I, II, III, IV, V, VI

System Description: pumped-pm - conventional

Repair System Description: same

Maintenance Agreement Required: ☐ Yes ☑ No

☑ House/Mod. Home No. Bedrooms 3

☐ Mobile Home No. Bathrooms 2

☐ Business No. Employees _____

☐ Other _____

☐ Slab ☑ Crawl Space ☐ Basement w/plumbing ☐ Basement wo/plumbing


Water Supply: ☑ Individual ☐ Community ☐ Public

Comments:


Comments:

1" = 100'

INITIAL SITE SKETCH

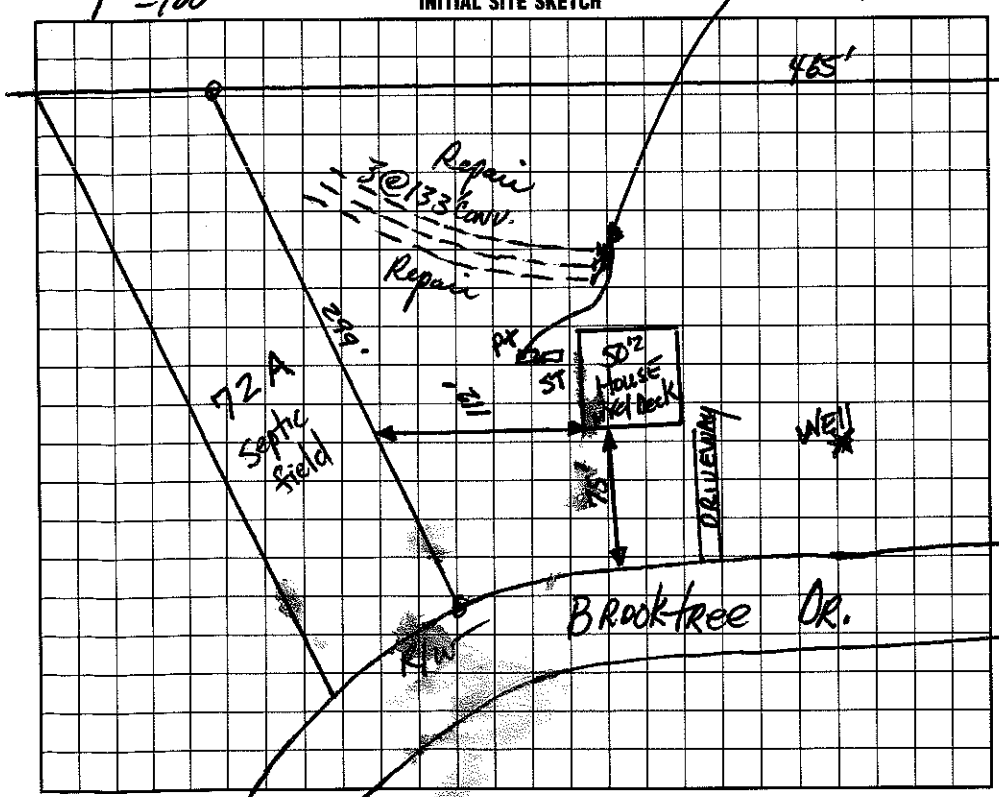

AS BUILT SKETCH

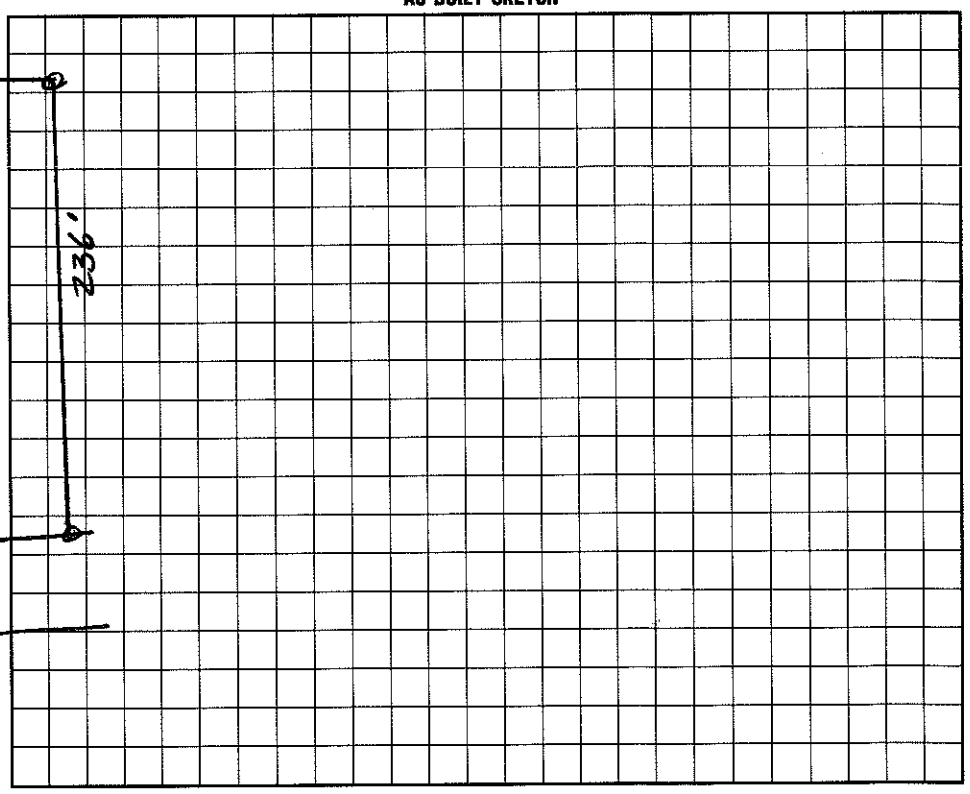

I understand that this permit can be suspended or revoked if any false information is supplied toward securing the permit/any unauthorized changes are made to the site/any unauthorized changes are made in the installation of the system. Improvement Permit is valid for 60 months from date of issuance.

Signed: A Johnson

Improvement Permit by: D Johnson, RS date 9-10-97

Authorization Construction D Johnson, RS date 9-10-97

Installed by: ROWAN SEPTIC

Certificate of Completion by: _____ date _____

Operation Permit by: Wesley Sparks RS. date 10/26/98

HEALTH DEPT. COPY: WHITE INSPECTION COPY (FINAL): GREEN OWNER COPY (FINAL): YELLOW INSPECTION COPY (INITIAL): PINK OWNER COPY (INITIAL): GOLD