IREDELL COUNTY HEALTH DEPARTMENT

Statesville Phone TR 3-7271 Mooresville Phone NO 3-1271

PERMIT TO INSTALL SEPTIC TANK

Permit No. 168 Permit Date 11-17- 1971

Owner mr. Sherrill Address Mooresville

Installed By Oswalt Address Troutman


Location of Property ½ mi down cornelius Rd.

Tank		Capacity		Length of Lines		Fixtures	
Block	( )	1000	(✓)	225'	(✓)	No. of Baths	(1)
Precast	(✓)	1250	( )	250'	( )	Dishwasher	( )
		1500	( )	Other		Garbage Grdr.	( )
		Other				Other	

NOTIFY HEALTH DEPARTMENT AT LEAST EIGHT HOURS BEFORE TANK IS TO BE INSPECTED.

Final Inspection 11-17-1971 Approved (✓) Disapproved ( )

Remarks

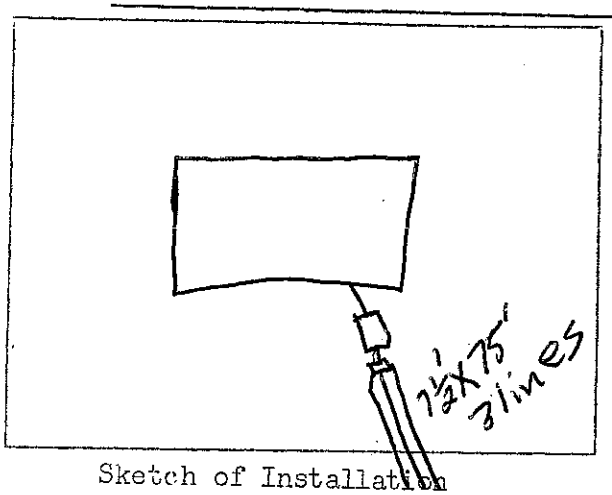

Sketch of Installation

May be Original permit.

J. C Moore

Sanitarian