IREDELL COUNTY HEALTH DEPARTMENT

STATESVILLE 704-878-5305 MOORESVILLE 704-664-5281

IMPROVEMENT PERMIT / AUTHORIZATION TO CONSTRUCT / OPERATION PERMIT / EXISTING SYSTEM INSPECTION

PERMIT# 140768 PIN# 4658242676 DATE 3-1-07

OWNER OR APPLICANT Chad Gopdin Signature Homes PHONE: Business 363-7302 Home 664-3499

ADDRESS 684 Normandy Rd Mooresville, NC 28117

LOCATION Hwy 21 North TL Cornelius Rd, property on right (before Cornelius Est) #252 Cornelius

SUBDIVISION N/A BLOCK / SECTION ____ LOT ____ LOT AREA 1.12 Acre SITE CLASS. PS DESIGN FLOW 360gpd L.T.A.R. .3

Septic Tank: 1000 Gallons; STB 1012 Date 1-26-07

Pump Tank: ____ Gallons; PT ____ Date ____

Pump Make: ____ Model ____ Serial No. ____

Nitrification Field: No Fields 1 Square Feet 900' Linear Feet 300'

No Lines 3@100 Trench Width 36" Max Trench Bottom Depth 30"

[X] New System [ ] Repair [ ] Expansion System Type: I II III IV V VI

System Description: Gravity-25% Reduction

Repair System Description: Innovative/Pump

Maintenance Agreement Required: [ ] Yes [X] No

Gravel Depth N/A [X] Gravity [ ] Pressure [ ] Slab [X] Crawl Space [ ] Basement w/plumbing [ ] Basement wo/plumbing

[X] House/Mod. Home [ ] Mobile Home [ ] Business [ ] Other

No. Bedrooms 3 No. Persons ____ No. Employees ____


Water Supply: [ ] Individual [X] Public [ ] Community

Comments:/Conditions:

PL 151.95

Comments:/Conditions: Note: Must "properly" abandon existing well prior to installation of Septic System.

INITIAL SITE SKETCH Scale 1:50

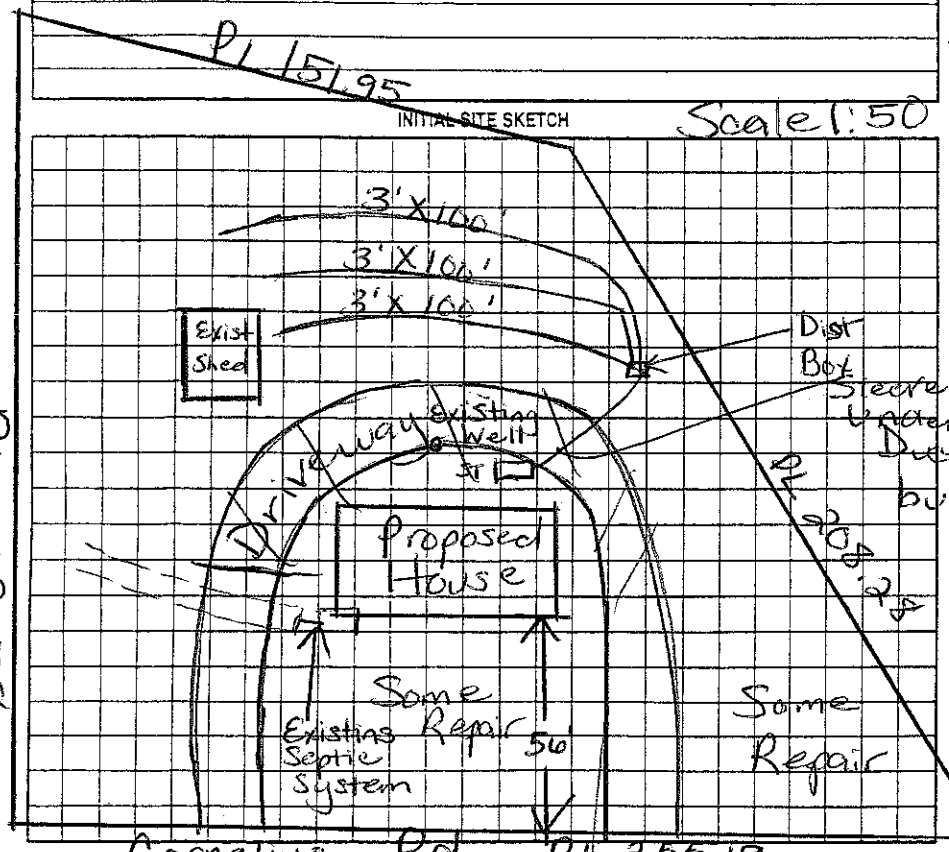

Steave Supply line under drive with Ductile iron or bury 30" or greater

AS BUILT SKETCH

- Quick 4.3, yellow poly. (de installed
- abandoned old well hooked onto city/town water
- Driveway doesn't go behind house - stops at side.

Permit can be suspended or revoked if any false information is supplied toward securing the permit/any unauthorized changes are made to the site/any unauthorized changes are made in the installation of the system. Improvement Permit with plat valid without expiration ☐ Improvement Permit with site plan valid for sixty months ☐ Authorization to Construct is valid for a period equal to that of Improvement Permit – not to exceed sixty months.

Signed: CW date 3/5/07

Improvement Permit by: Maria H. Hodgson RS date 3/1/07

Authorization to Construct by: Maria H. Hodgson RS date 3/1/07

Installed by: C & S Grading

Operation Permit by: Jeh E Alph date 7/10/07

Existing System Inspection by: ____ date ____

HEALTH DEPT. COPY: WHITE OWNER COPY (FINAL): YELLOW OWNER COPY (INITIAL): PINK