IREDELL COUNTY HEALTH DEPARTMENT

STATESVILLE 704-878-5305 MOORESVILLE 704-664-5281

IMPROVEMENT PERMIT / AUTHORIZATION TO CONSTRUCT / OPERATION PERMIT / EXISTING SYSTEM INSPECTION

PERMIT# 11759 PIN# 4658266534 DATE 5-19-03

OWNER OR CONTRACTOR Freedom Homes PHONE: Business 528-9449 Home

ADDRESS 1018 Charlotte Hwy Troutman, NC

LOCATION Hwy 21 N TL Bailey Rd TL, Evelyn on right

SUBDIVISION BLOCK / SECTION LOT LOT AREA 1.22Acres SITE CLASS. PS DESIGN FLOW 360gpd L.T.A.R. .3

Septic Tank: 1000 Gallons; STB 1012 Date 10-14-02 ☒ New System ☐ Repair System Type: I, II, III, IV, V, VI

Pump Tank: Gallons; PT Date System Description: Gravity-Conventional

Pump Make: Model Serial No. Repair System Description: Gravity-Innovative

Nitrification Field: No Fields 1 Square Feet 1200' Linear Feet 400' Maintenance Agreement Required: ☐ Yes ☒ No

No Lines 3@133' Trench Width 36" Max Trench Bottom Depth 24" Gravel Depth 12"

☐ House/Mod. Home ☒ Mobile Home ☐ Business ☐ Other

No. Bedrooms 3 No. Bathrooms 2 No. Employees

☐ Slab ☒ Crawl Space ☐ Basement w/plumbing ☐ Basement wo/plumbing


Water Supply: ☒ Individual ☐ Public ☐ Community

Comments:/Conditions: Keep Septic System at least 10' to PL & at least 50' to ~~deep~~ well (drainfield must be kept shallow) 100' setback to well if drainfield > 24" trench bottom

Comments:/Conditions: ★ Per attached letter from Energy United okay to put Drainfield in ROW (Initial Septic Field not in Row.

★ Not to Scale

INITIAL SITE SKETCH

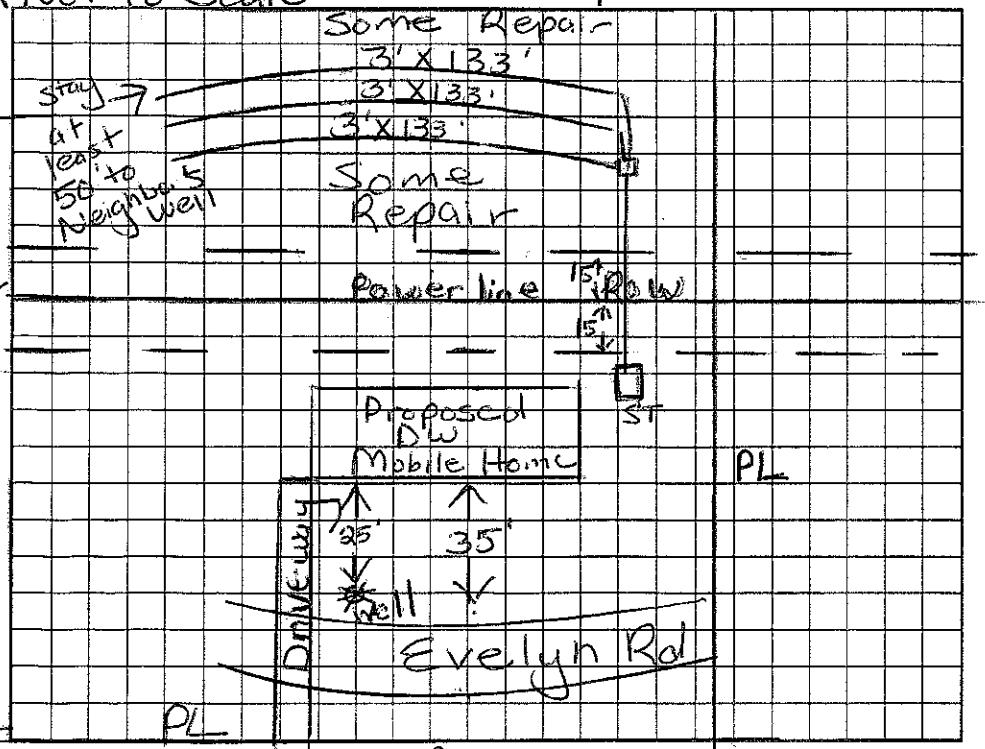

AS BUILT SKETCH

Yellow Filter & ST marker installed

Installed as Drawn

Conventional Drainfield

★ MH not set up yet when inspected

Permit can be suspended or revoked if any false information is supplied toward securing the permit/any unauthorized changes are made to the site/any unauthorized changes are made in the installation of the system. Improvement Permit with plat valid without expiration. Improvement Permit with site plan valid for sixty months. Authorization to Construct is valid for a period equal to that of Improvement Permit – not to exceed sixty months.

Signed: date 05-19-03 Installed by: A-1 Backhoe

Improvement Permit by: Maina M. Dotson R.S. date 5/19/03 Operation Permit by: Maina M. Dotson date 5/20/03

Authorization to Construct by: Maina M. Dotson R.S. date 5/19/03 Existing System Inspection by: date

HEALTH DEPT. COPY: WHITE OWNER COPY (FINAL): YELLOW OWNER COPY (INITIAL): PINK