IREDELL COUNTY HEALTH DEPARTMENT

STATESVILLE 704-878-5305 MOORESVILLE 704-664-5281

IMPROVEMENT PERMIT / AUTHORIZATION TO CONSTRUCT / OPERATION PERMIT / EXISTING SYSTEM INSPECTION

PERMIT# 076214 PIN# 4658271342

OWNER OR CONTRACTOR Robert Blanton PHONE: Business Pg. 881-6525 Home 662-9730 DATE 9/14/98

ADDRESS 326 Bailey Rd Mooresville

LOCATION US 21 N TO Bailey Rd ~ 1 mile on Rt.

SUBDIVISION _____ BLOCK / SECTION _____ LOT _____ LOT AREA 7.41 SITE CLASS PS DESIGN FLOW 480gpd L.T.A.R. 3

Septic Tank: Existing Gallons; STB _____ Date _____

Pump Tank: _____ Gallons; PT _____ Date _____

Pump Make: _____ Model _____ Serial No. _____

Nitrification Field: No Fields 1 Square Feet 300 Linear Feet 100'

Addition No Lines 2 at 50' Trench Width 36" Max Trench Bottom Depth 18"

☐ New System ☐ Repair System Type: I, II, III, IV, V, VI

System Description: Gravity Conventional

Repair System Description: _____

Maintenance Agreement Required: ☐ Yes ☒ No

Gravel Depth 12" ☒ Slab ☐ Crawl Space ☐ Basement w/plumbing ☐ Basement wo/plumbing

☒ House/Mod. Home No. Bedrooms 4

☐ Mobile Home No. Bathrooms 3

☐ Business No. Employees _____


☐ Other _____

Water Supply: ☒ Individual ☐ Public ☐ Community


Comments:/Conditions: Upgrade to 4 Bedroom
Add 2 lines at 50' each (Split Flow btw 2 new lines)
Not to Scale

Comments:/Conditions: Existing MH will be removed. Septic System appeared to be functioning okay at time of inspection, however some signs of past failures.

INITIAL SITE SKETCH

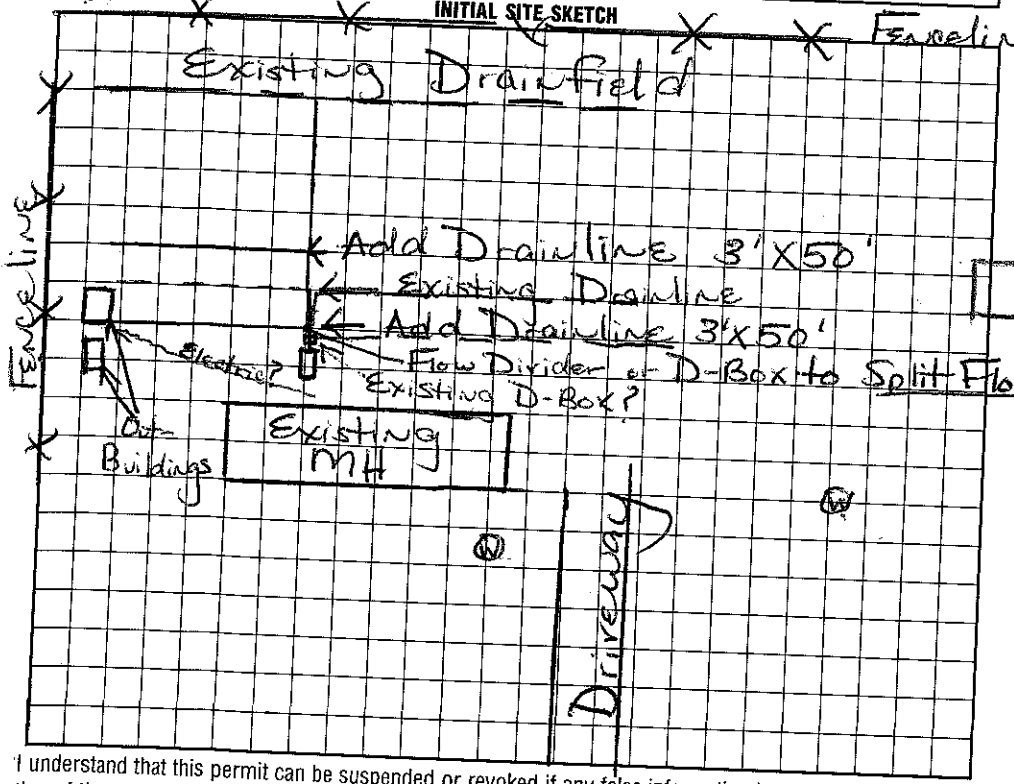

AS BUILT SKETCH

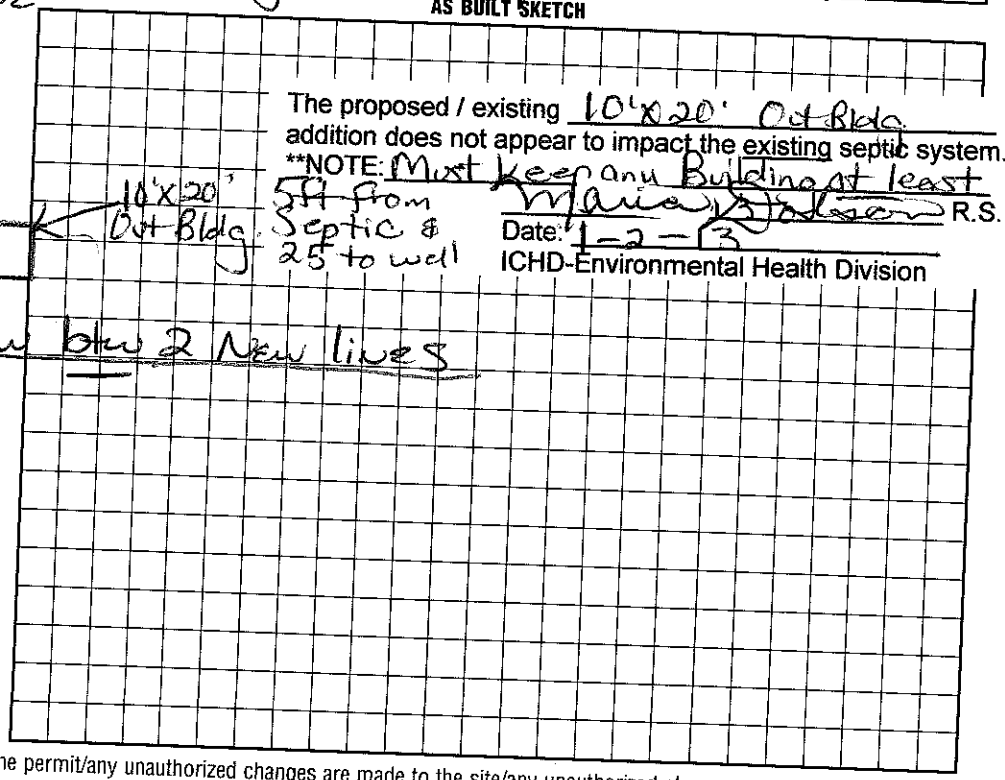

The proposed / existing 10'X20' Out Bldg. addition does not appear to impact the existing septic system.

**NOTE: Must keep any Building at least 5ft from Septic & 25 to well

Maria H. Dotson R.S.

Date: 1-2-3

ICHD-Environmental Health Division

I understand that this permit can be suspended or revoked if any false information is supplied toward securing the permit/any unauthorized changes are made to the site/any unauthorized changes are made in the installation of the system. Improvement Permit with plat valid without expiration. Improvement Permit with site plan valid for sixty months. Authorization to Construct is valid for a period equal to that of Improvement Permit – not to exceed sixty months.

Signed: X Bonnie W. Blanton

Improvement Permit by: Maria H. Dotson date 9/14/98

Authorization to Construct by: Maria H. Dotson date 9/14/98

Installed by: Rosemen Grading

Operation Permit by: _____ date _____

Existing System Inspection by: Maria Dotson date 9/14/98

HEALTH DEPT. COPY: WHITE INSPECTION COPY (FINAL): GREEN OWNER COPY (FINAL): YELLOW INSPECTION COPY (INITIAL): PINK OWNER COPY (INITIAL): GOLD