IREDELL COUNTY HEALTH DEPARTMENT

STATESVILLE 704-878-5305 MOORESVILLE 704-664-5281

IMPROVEMENT PERMIT / ~~CERTIFICATE OF COMPLETION~~ / OPERATION PERMIT / EXISTING SYSTEM INSPECTION

PROPERTY DESCRIPTION NO. 065792 DATE 4/15/97 TAX MAP NO. 4658275346 Watershed: ☑ Yes ☐ No

OWNER OR CONTRACTOR BILLY RAY WRIGHT PHONE: Business _____ Home _____

ADDRESS 364 BAILEY RD. MOORESVILLE NC 28115

LOCATION ~~3364~~ 21 N - TL BAILEY RD ON RT

SUBDIVISION _____ BLOCK / SECTION - LOT - LOT AREA ~2 AC SITE CLASS. PS DESIGN FLOW 240 GPD L.T.A.R. ~.36 GPD/FT

Septic Tank: 1000 Gallons; STB 825 Date 2/10/97

Pump Tank: _____ Gallons; PT _____ Date _____

Pump Make: _____ Model _____ Serial No. _____

Nitrification Field: No Fields 1 Square Feet 510 Linear Feet 270

No Lines 3@90' Trench Width 36" Max Trench Bottom Depth 24"

☑ New System ☐ Repair System Type: I (II) III, IV, V, VI

System Description: GRAVITY CONVENTIONAL

Repair System Description: CHAMBERED OR SIMILAR

Maintenance Agreement Required: ☐ Yes ☑ No TYPE

Gravel Depth 12"

☑ House/Mod. Home No. Bedrooms 3

☑ Mobile Home No. Bathrooms 2

☐ Business No. Employees _____

☐ Other _____


☐ Slab ☑ Crawl Space ☐ Basement w/plumbing ☐ Basement wo/plumbing

Water Supply: ☑ ~~Individual~~ ☐ Community ☐ Public

Comments:


Comments: MOBILE HOME NOT LOCATED AT TIME OF INSPECTION 5/6/97 (cmg 2nd)

INITIAL SITE SKETCH

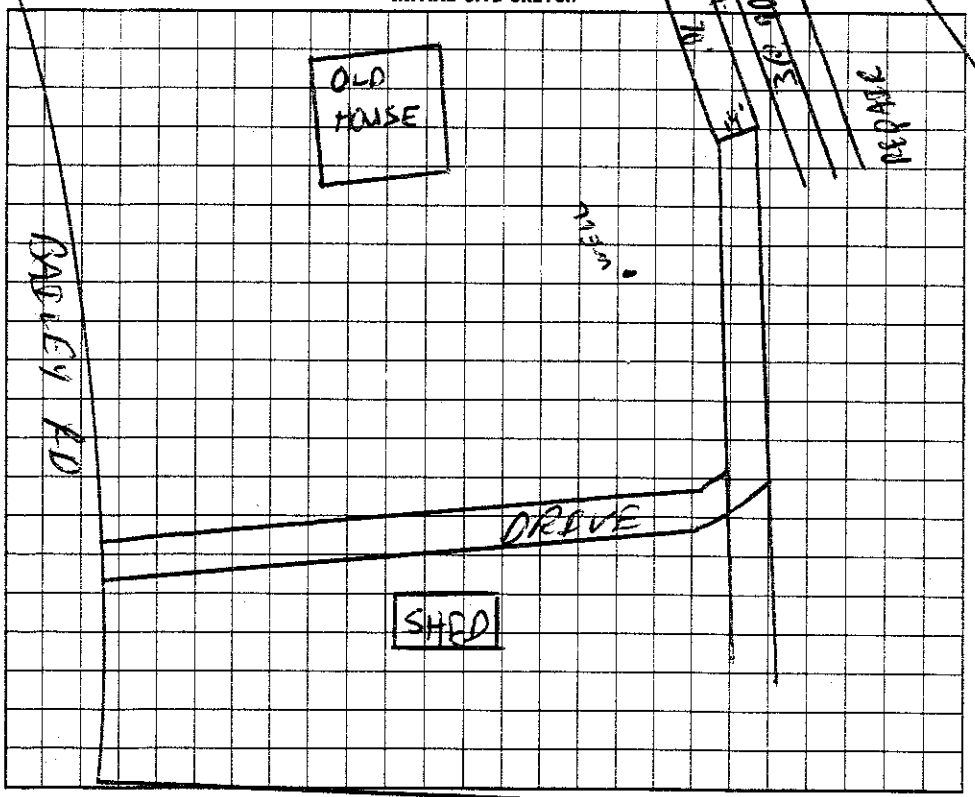

1" = 60'

AS BUILT SKETCH

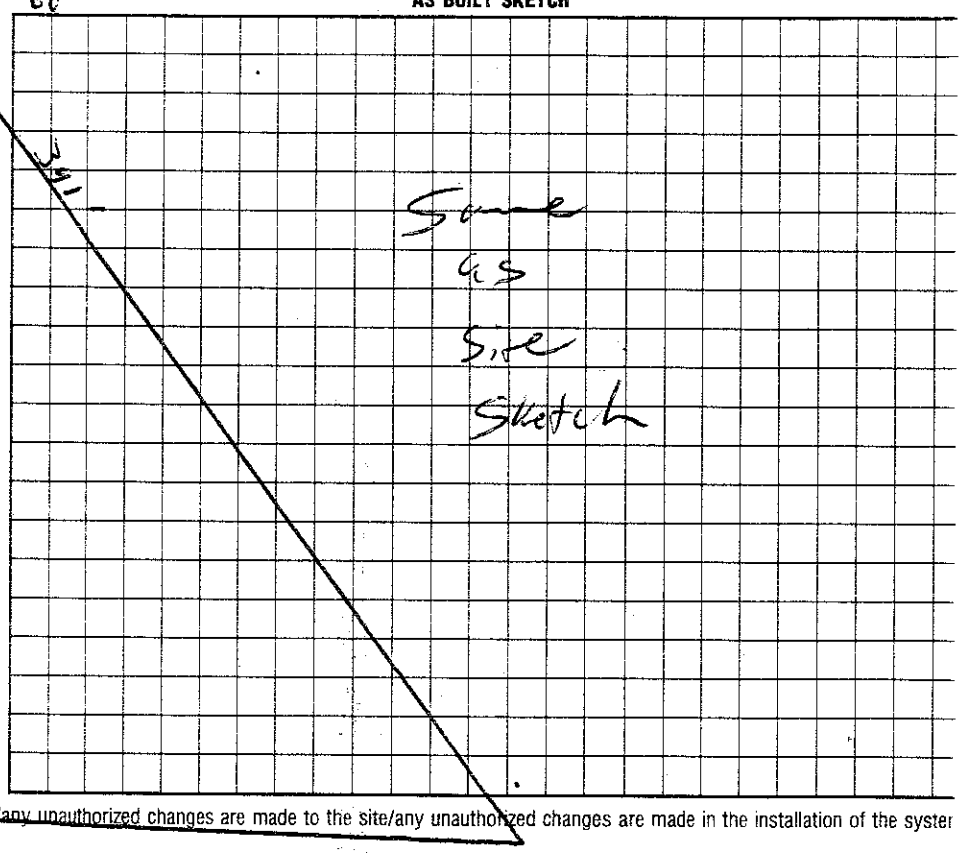

I understand that this permit can be suspended or revoked if any false information is supplied toward ~~securing the permit~~/any unauthorized changes are made to the site/any unauthorized changes are made in the installation of the syster Improvement Permit is valid for 60 months from date of issuance.

Signed: Billy Ray Wright

Improvement Permit by: C. [signature] date 4/21/97

~~Existing System Inspection by:~~ AUTHORIZATION TO CONSTRUCT C. [signature] date 4/21/97

Installed by: FOSTER POOL

Certificate of Completion by: _____ date _____

Operation Permit by: C. [signature] date 5/6/97

HEALTH DEPT. COPY: WHITE INSPECTION COPY (FINAL): GREEN OWNER COPY (FINAL): YELLOW INSPECTION COPY (INITIAL): PINK OWNER COPY (INITIAL): GOLD