IREDELL COUNTY HEALTH DEPARTMENT - *ENVIRONMENTAL HEALTH* ☐ STATESVILLE OFFICE 704-878-5305 ☒ MOORESVILLE OFFICE 704-664-5281

IMPROVEMENT PERMIT / AUTHORIZATION TO CONSTRUCT / OPERATION PERMIT / EXISTING SYSTEM INSPECTION

PERMIT # 169617 PIN # 4658-28-66000 DATE 1-4-18

OWNER BRAD GRIGGS APPLICANT: SAME PHONE: Home/Cell # 704-818-7499 Business #

SITE ADDRESS 000 M&M FARMS RD OWNER / APPLICANT ADDRESS

SITE DIRECTIONS HWY 21, BARFIELD, M&M CUERY END

SUBDIVISION — BLOCK / SECTION — LOT # — LOT AREA 2.738 AC DESIGN FLOW 480 GAL/DAY L.T.A.R. .3

Septic Tank 1000 Gallons: STB 1012 Date 9-29-11 ☒ New System ☐ Repair ☐ Expansion System Type I II (III) IV V VI

Pump Tank — Gallons: P T — Date — System Description: 25% RED

Pump Make — Model — Serial # — Repair System Description: SAME

No. Nitrification Fields: 1 No. Lines 5 Linear Feet 400' Maintenance Agreement Required ☐ YES ☒ NO

Trench Width 36" Max. Trench Bottom Depth 36" Gravel Depth — ☒ GRAVITY ☐ PRESSURE


☒ Residence No. Bedrooms 4 ☐ Business No. Persons — ☐ Other No. Employees — ☐ Slab ☒ Crawl Space ☐ Basement w/plumbing ☐ Basement w/o plumbing

Water Supply ☒ Private ☐ Public ☐ Community

Comments / Conditions 1/10/12 Reviewed Floor plans

PROPOSED WELL

INITIAL SITE SKETCH

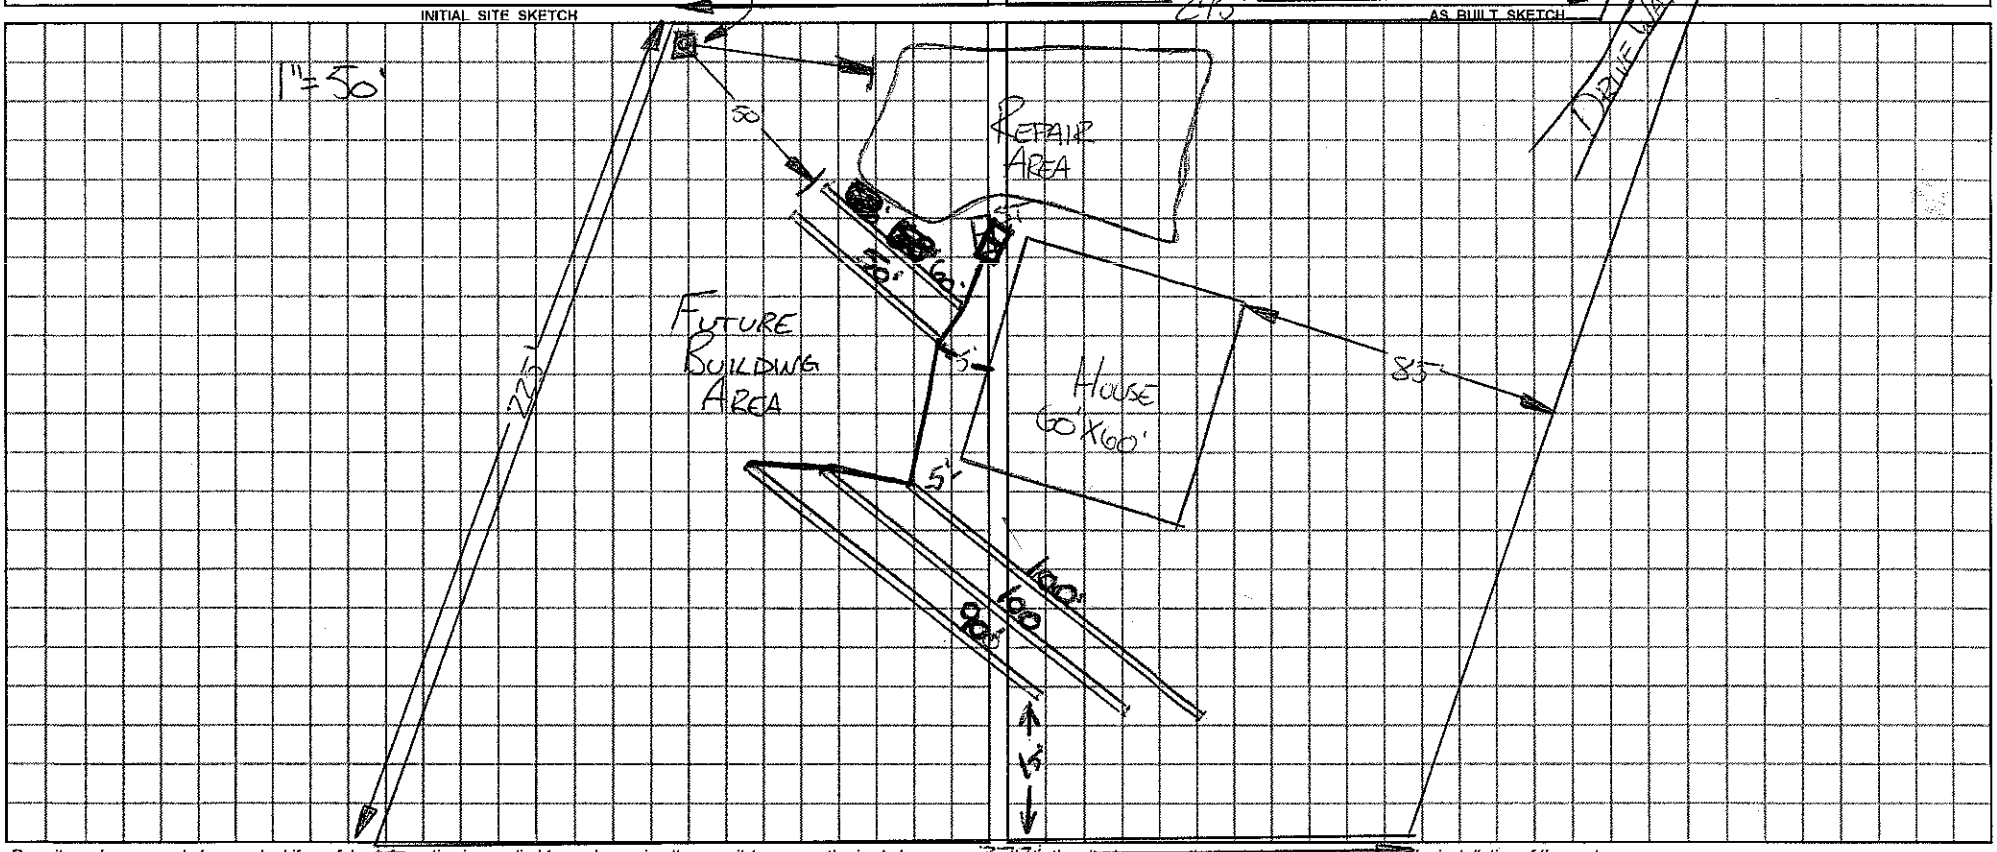

AS BUILT SKETCH

Permit can be suspended or revoked if any false information is supplied toward securing the permit / any unauthorized changes are made to the site / any unauthorized changes are made in the installation of the system.

☐ ***IMPROVEMENT PERMIT*** with plat valid without expiration. ☐ ***IMPROVEMENT PERMIT*** with plat valid without expiration. site plan valid 60 mo. ☐ ***AUTHORIZATION TO CONSTRUCT*** valid for period equal to IMPROVEMENT PERMIT--not to exceed 60 mo.

Owner / Applicant Signature: [signature] Date 1-6-12 Installed by: GUNTER

IMPROVEMENT PERMIT by: [signature] REHS Date 1-4-12 OPERATION PERMIT by: [signature] REHS Date 2-23-12

AUTHORIZATION TO CONSTRUCT by: [signature] REHS Date 1/10/12 Existing System Inspected by: REHS Date

YOU SHOULD CONTACT A LOCATOR SERVICE PRIOR TO ANY EXCAVATION

White Copy -- Environmental Health YELLOW COPY (Final) Owner / Applicant PINK COPY (Initial) Owner / Applicant