3-00

IREDELL COUNTY HEALTH DEPARTMENT Const. Auth. · STATESVILLE 704-878-5305 MOORESVILLE 704-664-5281

IMPROVEMENT PERMIT / ~~CERTIFICATE OF COMPLETION~~ / OPERATION PERMIT / EXISTING SYSTEM INSPECTION

PROPERTY DESCRIPTION NO. 24665 DATE June 19, 1997 TAX MAP NO. part of 12A5 Watershed: ☑ Yes ☐ No

OWNER OR CONTRACTOR Kapp Financial Services PHONE: Business ~~Home~~ 4658-30-1905

ADDRESS 149 Yacht Cove Rd, Mooresville

LOCATION 21N. TL Valleyview ~100 yds on Right

SUBDIVISION Oakbrook BLOCK / SECTION LOT 80 LOT AREA .8Ac SITE CLASS. PS DESIGN FLOW 360 gpd L.T.A.R. .3

Septic Tank: 1000 Gallons; STB ~~825~~ Date 12/5/97

Pump Tank: Gallons; PT Date

Pump Make: Model Serial No.

Nitrification Field: No Fields 1 Square Feet 1200 Linear Feet 400

No Lines 3-4 Trench Width 36" Max Trench Bottom Depth ~30" Gravel Depth 12"

☑ New System ☐ Repair System Type: I, II, III, IV, V, VI

System Description: gravity conventional

Repair System Description: Same

Maintenance Agreement Required: ☐ Yes ☑ No

☐ House/Mod. Home No. Bedrooms 3

☐ Mobile Home No. Bathrooms 2

☐ Business No. Employees

☐ Other

☑ Slab ☐ Crawl Space ☐ Basement w/plumbing ☐ Basement wo/plumbing


Water Supply:
☑ Individual
☐ Community
☐ Public

Comments:

Comments:

1" = 100'

INITIAL SITE SKETCH

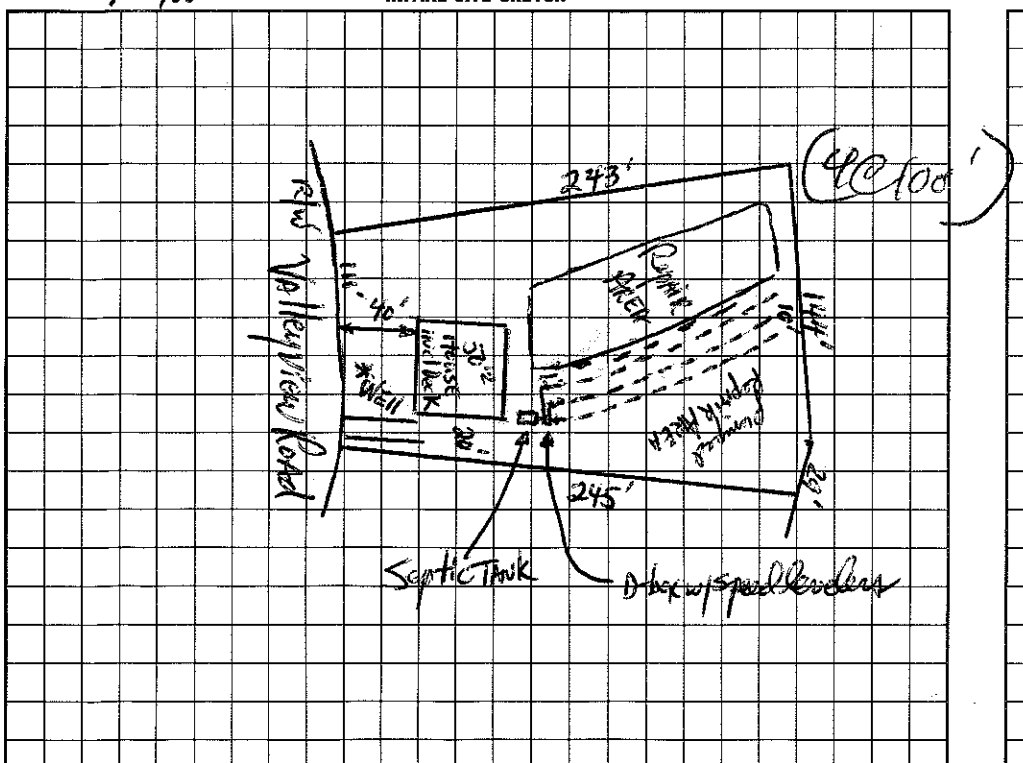

AS BUILT SKETCH

AS SHOWN

I understand that this permit can be suspended or revoked if any false information is supplied toward securing the permit/any unauthorized changes are made to the site/any unauthorized changes are made in the installation of the system. Improvement Permit is valid for 60 months from date of issuance.

Signed:

Improvement Permit by: D. Hartman, RS date 6-19-97

~~Existing System Inspection by:~~ Construction Authorization by: D. Hartman RS date 6-19-97

Installed by: ROWAN SEPTIC

Certificate of Completion by: date

Operation Permit by: date 3/2/98

HEALTH DEPT. COPY: WHITE INSPECTION COPY (FINAL): GREEN OWNER COPY (FINAL): YELLOW INSPECTION COPY (INITIAL): PINK OWNER COPY (INITIAL): GOLD