# IREDELL COUNTY HEALTH DEPARTMENT

STATESVILLE 704-878-5305 130.00 Paid MOORESVILLE 704-664-5281

## IMPROVEMENT PERMIT / AUTHORIZATION TO CONSTRUCT / OPERATION PERMIT / EXISTING SYSTEM INSPECTION

PERMIT# 126454 PIN# ~~4658-30-2379~~ 4658 30 2247 DATE 2/21/05

OWNER OR CONTRACTOR Tom Summerville PHONE: Business _____ Home 704 664-1191

ADDRESS Po Box 3561 Mooresville NC 28117

LOCATION 150 W, TR 21 N, on Lt 2nd Past Brantley Place

SUBDIVISION _____ BLOCK / SECTION _____ LOT _____ LOT AREA 0.64AC SITE CLASS. PS DESIGN FLOW 240 L.T.A.R. 0.25 I / 0.125 R

Septic Tank: 1080 Gallons; STB 794 Date 4/30/05
Pump Tank: _____ Gallons; PT _____ Date _____
Pump Make: _____ Model _____ Serial No. _____
Nitrification Field: No Fields 1 Square Feet 720' Linear Feet 240
No Lines 4 Trench Width 36" Max Trench Bottom Depth 24"

☒ New System ☐ Repair System Type: I, II, (III), IV, V, VI
System Description: Gravity 25% Reduction LPP
Repair System Description: _____
Maintenance Agreement Required: ☐ Yes ☒ No

☒ House/Mod. Home No. Bedrooms 3
☐ Mobile Home No. Bathrooms ____
☐ Business No. Employees ____
☐ Other _____


Water Supply: ☒ Individual ☐ Public ☐ Community

Gravel Depth —
☐ Slab ☒ Crawl Space ☐ Basement w/plumbing ☐ Basement wo/plumbing


Comments:/Conditions:

Comments:/Conditions:

INITIAL SITE SKETCH

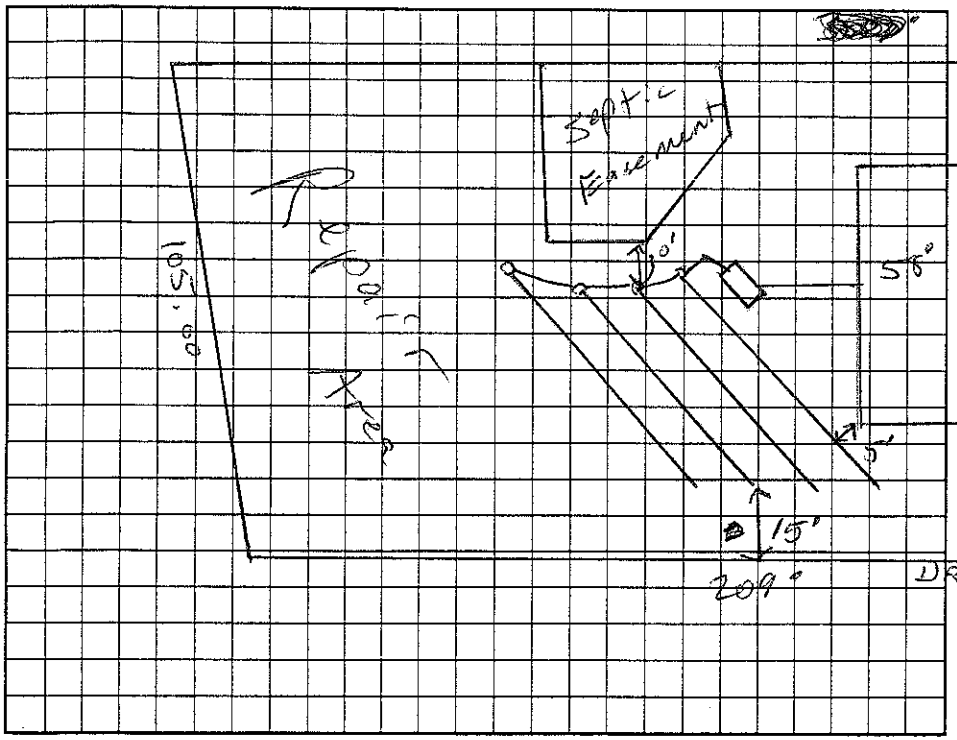


AS BUILT SKETCH

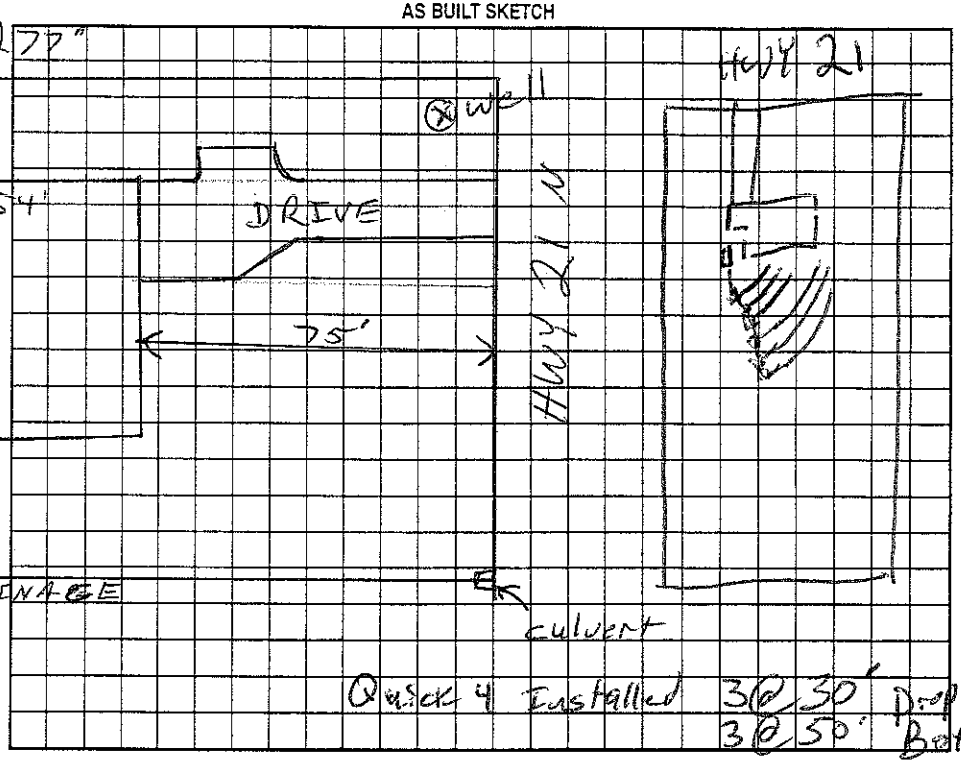


Permit can be suspended or revoked if any false information is supplied toward securing the permit/any unauthorized changes are made to the site/any unauthorized changes are made in the installation of the system. Improvement Permit with plat valid without expiration. Improvement Permit with site plan valid for sixty months. Authorization to Construct is valid for a period equal to that of Improvement Permit – not to exceed sixty months.

Signed: Tom Summerville date 2-21-05 Installed by: Abernathy

Improvement Permit by: RS date 2/21/05 Operation Permit by: RS date 7/6/05

Authorization to Construct by: RS date 2/21/05 Existing System Inspection by: _____ date _____

HEALTH DEPT. COPY: WHITE OWNER COPY (FINAL): YELLOW OWNER COPY (INITIAL): PINK