3:00

IREDELL COUNTY HEALTH DEPARTMENT Const Auth STATESVILLE 704-878-5305 MOORESVILLE 704-664-5281

IMPROVEMENT PERMIT / ~~CERTIFICATE OF COMPLETION~~ / OPERATION PERMIT / EXISTING SYSTEM INSPECTION

PROPERTY DESCRIPTION NO. 2462 DATE 8-25-97 TAX MAP NO. part of 1LA5 Watershed: ☑ Yes ☐ No

OWNER OR CONTRACTOR Krym Financial Services PHONE: Business ~~Home~~ 4658-31-0253

ADDRESS 149 Yacht Cove Rd. Mooresville

LOCATION

SUBDIVISION Oakbrook BLOCK / SECTION LOT 83 LOT AREA 2.17Ac SITE CLASS. PS DESIGN FLOW 360gpd L.T.A.R. .3

Septic Tank: 1000 Gallons; STB RST 825 Date 8-24-97
Pump Tank: Gallons; PT Date
Pump Make: Model Serial No.
Nitrification Field: No Fields 1 Square Feet 1200 Linear Feet 400
No Lines 3@133' Trench Width 36" Max Trench Bottom Depth ~18" Gravel Depth 12"

☑ New System ☐ Repair System Type: I, II, III, IV, V, VI
System Description: gravity conventional
Repair System Description: same
Maintenance Agreement Required: ☐ Yes ☑ No


☑ House/Mod. Home No. Bedrooms 3
☐ Mobile Home No. Bathrooms 2
☐ Business No. Employees
☐ Other
☑ Slab ☐ Crawl Space ☐ Basement w/plumbing ☐ Basement wo/plumbing

Water Supply: ☑ Individual ☐ Community ☐ Public

Comments:

Comments:

INITIAL SITE SKETCH 1"=100'

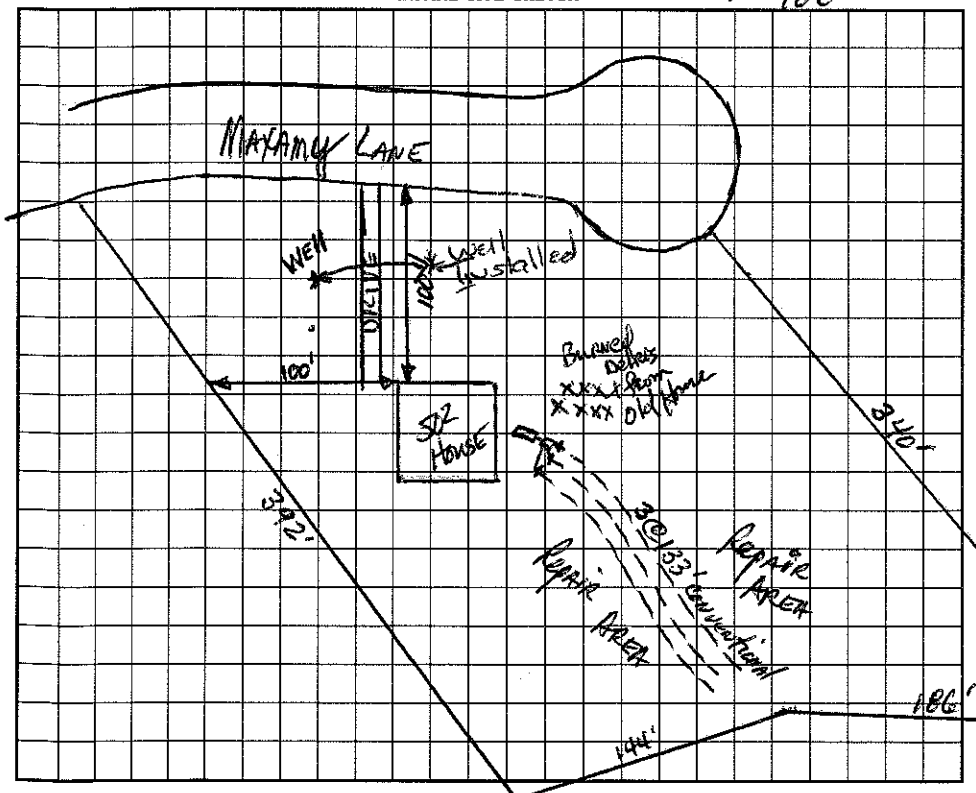

AS BUILT SKETCH

Installed as Drawn

I understand that this permit can be suspended or revoked if any false information is supplied toward securing the permit/any unauthorized changes are made to the site/any unauthorized changes are made in the installation of the system. Improvement Permit is valid for 60 months from date of issuance.

Signed:

Improvement Permit by: RS date 8-25-97

~~Existing System Inspection by:~~ Construction Authorization RS date 8-25-97

Installed by: Rowan Septic

Certificate of Completion by: date 10/14/97

Operation Permit by: date 10/14/97

HEALTH DEPT. COPY: WHITE INSPECTION COPY (FINAL): GREEN OWNER COPY (FINAL): YELLOW INSPECTION COPY (INITIAL): PINK OWNER COPY (INITIAL): GOLD