3:30-4:00

IREDELL COUNTY HEALTH DEPARTMENT Const. Auth.

STATESVILLE 704-878-5305 MOORESVILLE 704-664-5281

IMPROVEMENT PERMIT / ~~CERTIFICATE OF COMPLETION~~ / OPERATION PERMIT / EXISTING SYSTEM INSPECTION

PROPERTY DESCRIPTION NO. 24661 DATE 8-25-97 TAX MAP NO. part of 12A5 4658 31 2373 Watershed: ☑ Yes ☐ No

OWNER OR CONTRACTOR Keam Financial Services PHONE: Business _____ Home _____

ADDRESS 149 Yacht Cove Rd.

LOCATION US21 N. TL Valleyview TR Brooklee TR Maxamy at end

SUBDIVISION Oakrock BLOCK / SECTION _____ LOT 82 LOT AREA 1.67Ac SITE CLASS. 15 DESIGN FLOW 360gpd L.T.A.R. .3

Septic Tank: 1000 Gallons; STB 825 Date 7/18/98

Pump Tank: 1000 Gallons; PT 47 Date 6/11/98

Pump Make: _____ Model _____ Serial No. _____

Nitrification Field: No Fields 1 Square Feet 1200 Linear Feet 400

No Lines 3@133' Trench Width 36" Max Trench Bottom Depth 18" Gravel Depth 12"

☑ New System ☐ Repair System Type: I, II, (III), IV, V, VI

System Description: pumped-pvc - Conventional

Repair System Description: Same

Maintenance Agreement Required: ☐ Yes ☑ No

☑ House/Mod. Home No. Bedrooms 3

☐ Mobile Home No. Bathrooms 2

☐ Business No. Employees _____

☐ Other _____

☑ Slab ☐ Crawl Space ☐ Basement w/plumbing ☐ Basement wo/plumbing


Water Supply: ☑ Individual ☐ Community ☐ Public

Comments:

Comments:

1"=100'

INITIAL SITE SKETCH

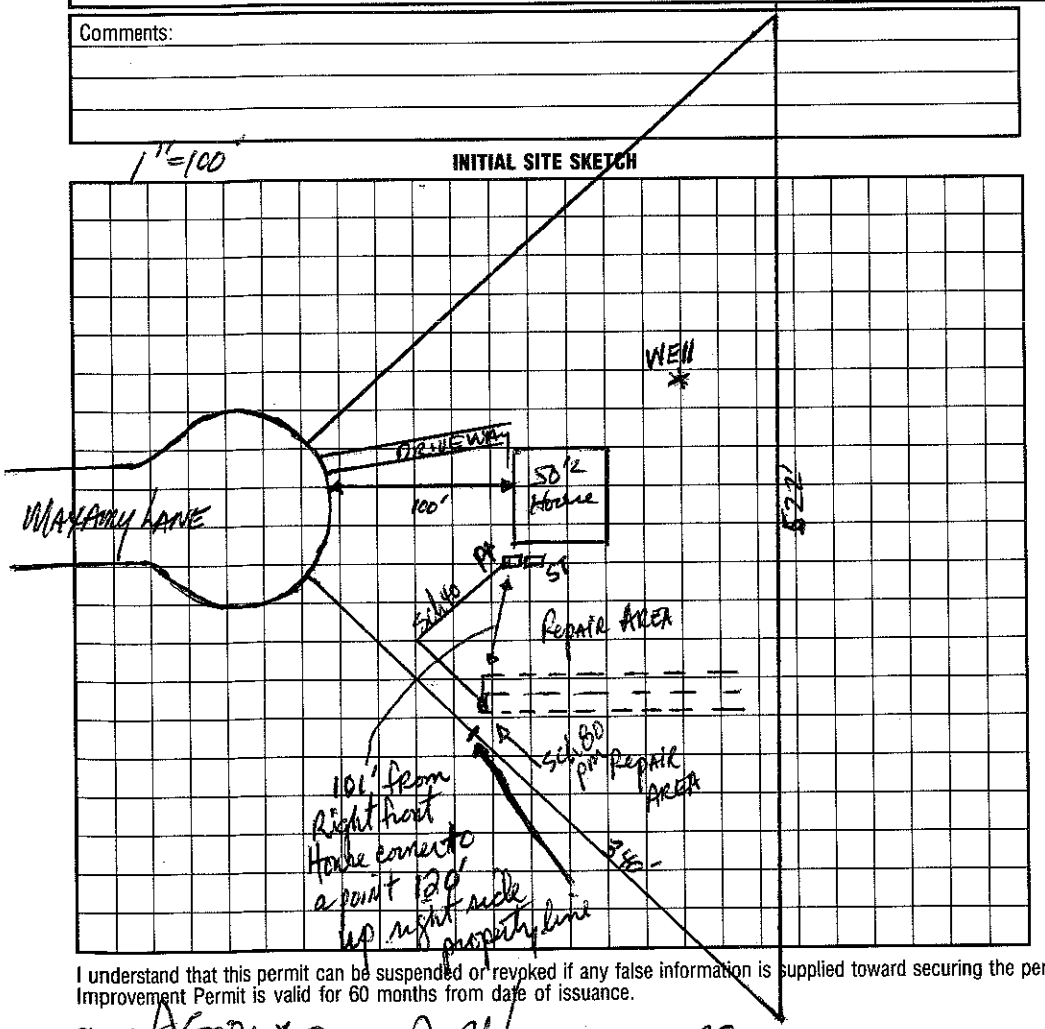

AS BUILT SKETCH

I understand that this permit can be suspended or revoked if any false information is supplied toward securing the permit/any unauthorized changes are made to the site/any unauthorized changes are made in the installation of the system. Improvement Permit is valid for 60 months from date of issuance.

Signed: _____

Improvement Permit by: _____ RS date 8-25-97

~~Existing System Inspection by:~~ Construction Authorization _____ RS date 8-25-97

Installed by: ROWAN SEPTIC

Certificate of Completion by: Wesley Sparks RS. date 9/11/98

Operation Permit by: _____ date _____

HEALTH DEPT. COPY: WHITE INSPECTION COPY (FINAL): GREEN OWNER COPY (FINAL): YELLOW INSPECTION COPY (INITIAL): PINK OWNER COPY (INITIAL): GOLD