IREDELL COUNTY HEALTH DEPARTMENT

Statesville Office (704) 878-5305 Mooresville Office (704) 660-3625 PERMIT # 210406

IMPROVEMENT PERMIT / AUTHORIZATION TO CONSTRUCT / OPERATION PERMIT / EXISTING SYSTEM

PIN # 4658-31-2373.000

APPLICANT: John Sears APPLICANT ADDRESS: 128 Mayamy Ln.

SITE ADDRESS: 128 Mayamy Ln. Mooresville NC PHONE: 704-677-2215 ALT. PHONE:


SITE DIRECTIONS: Hwy 21 N From 115. TR Valleyview, TR Briartree, TR Mayamy, Site At End

SUBDIVISION: Oak Brook SECTION: LOT # 82 LOT AREA: 1.670 Acre DESIGN FLOW: Ex. 360 GPD L.T.A.R.: Existing


Septic Tank Existing (gal)	STB Ex.	Date Ex.	☐ New System ☐ Repair ☐ Expansion System Type: I II (III) IV V VI		☒ Residence	No. Bedrooms Ex. 3	Water Supply
Pump Tank Existing (gal)	PT Ex.	Date Ex.	System Description: Existing PM Conventional		☐ Business	No. Persons Ex. 6	☒ Private
Pump Make Ex.	Model	Serial #	Repair System Description: Same		☐ Other	No. Employees	☐ Public
# Nitrification Fields Ex.	# Lines Existing 3	Linear Ft: Existing	Maintenance Agreement Required: ☐ YES ☒ NO		☒ Slab	☐ Crawl Space	☐ Community
Trench Width Existing	Max. Trench Bottom Depth Existing	Gravel Depth Existing	☐ GRAVITY ☒ PRESSURE		☐ Basement w/plumbing	☐ Basement w/o plumbing	

Comments / Conditions: System Appeared To Be Functioning At Time of Inspection. Maintain 5' Separation With Any Building Structures.

INITIAL SITE SKETCH

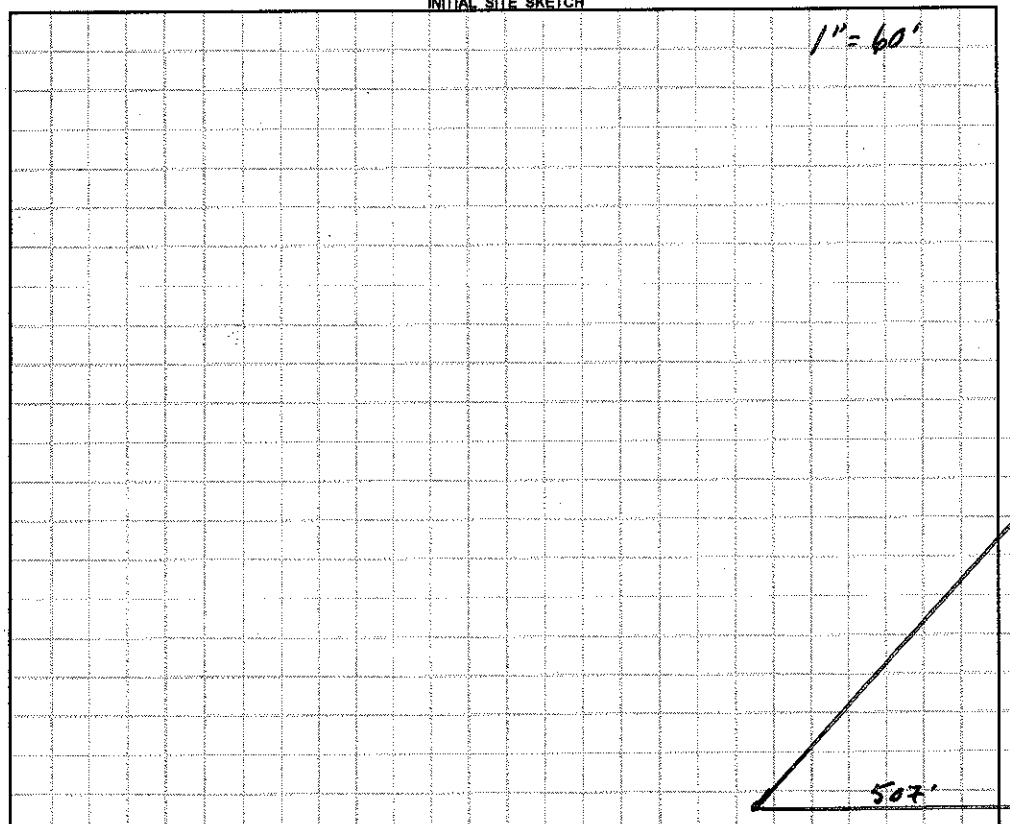

AS BUILT SKETCH

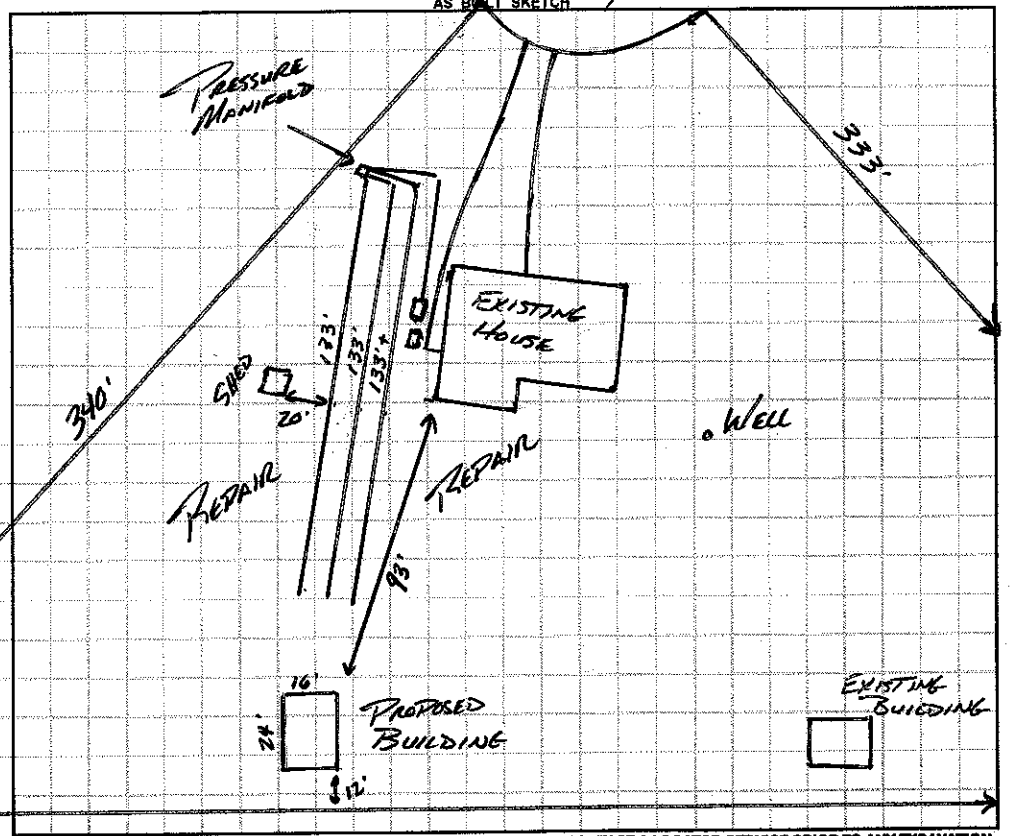

Permit can be suspended or revoked if any false information is supplied toward securing the permit / any unauthorized changes are made to the site / any unauthorized changes are made in the installation of the system. **CONTACT A LOCATOR SERVICE PRIOR TO ANY EXCAVATION**

☐ **IMPROVEMENT PERMIT** *with plat valid without expiration.* ☐ **IMPROVEMENT PERMIT** *with site plan valid for 60 mos.* ☐ **AUTHORIZATION TO CONSTRUCT** *valid for period equal to IMPROVEMENT PERMIT--not to exceed 60 mo.*

Owner / Applicant Signature: John J Sears Date: 6-10-2015 Installed by:

IMPROVEMENT PERMIT by: Date: OPERATION PERMIT by: Date:

AUTHORIZATION TO CONSTRUCT by: Date: Existing System Inspected by: APPROVED Date: JUN 09 2015

Health Dept. Copy - WHITE Applicant (Final Approval) - YELLOW Applicant (Conditional Approval) - PINK