IREDELL COUNTY HEALTH DEPARTMENT Const. Auth STATESVILLE 704-878-5305 MOORESVILLE 704-664-5281

IMPROVEMENT PERMIT / ~~CERTIFICATE OF COMPLETION~~ / OPERATION PERMIT / EXISTING SYSTEM INSPECTION

PROPERTY DESCRIPTION NO. 24657 DATE Aug 27, '97 TAX MAP NO. part of 1LA5 4658 31 2753 Watershed: ☑ Yes ☐ No

OWNER OR CONTRACTOR Bryan Financial Services PHONE: Business 664-3671 Home

ADDRESS 149 Yacht Cove Rd, Mooresville

LOCATION 21 N. TL Valleyview TR Brooktree on Right at end

SUBDIVISION Oakbrook BLOCK / SECTION LOT 78 LOT AREA 2.15Ac SITE CLASS. RS DESIGN FLOW 360gpd L.T.A.R. .3

Septic Tank: 1000 Gallons; STB 825 Date 8/11/98

Pump Tank: 1000 Gallons; PT 47 Date 8/11/98

Pump Make: Model Serial No.

Nitrification Field: No Fields 1 Square Feet 1200 Linear Feet 400

No Lines 4@100' Trench Width 36" Max Trench Bottom Depth ~18" Gravel Depth 12"

☑ New System ☐ Repair System Type: I, II, III, IV, V, VI

System Description: pumped-pm-conventional

Repair System Description: Some

Maintenance Agreement Required: ☐ Yes ☑ No

☑ House/Mod. Home No. Bedrooms 3

☐ Mobile Home No. Bathrooms 2

☐ Business No. Employees

☐ Other


☐ Slab ☑ Crawl Space ☐ Basement w/plumbing ☐ Basement wo/plumbing

Water Supply: ☑ Individual ☐ Community ☐ Public

Comments: USE sch 80 pressure manifold w/ 4, ½" taps

Comments:

INITIAL SITE SKETCH

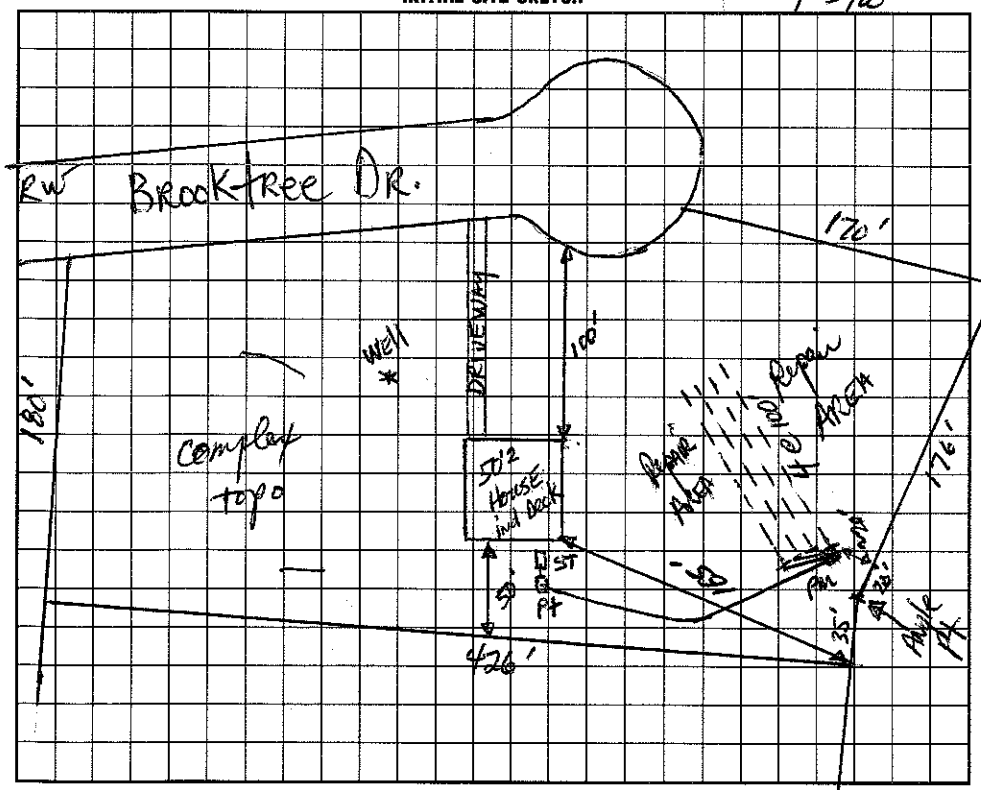

AS BUILT SKETCH

I understand that this permit can be suspended or revoked if any false information is supplied toward securing the permit/any unauthorized changes are made to the site/any unauthorized changes are made in the installation of the system. Improvement Permit is valid for 60 months from date of issuance.

Signed: A Soyars

Improvement Permit by: DR Huson, RS date 8-27-97

~~Existing System Inspection by:~~ Construction DR Huson, RS date 8-27-97

Installed by:

Certificate of Completion by: Maria H Dotson date 11/24/98

Operation Permit by: Maria H Dotson RS date 11/24/98

Arthur Soyars

HEALTH DEPT. COPY: WHITE INSPECTION COPY (FINAL): GREEN OWNER COPY (FINAL): YELLOW INSPECTION COPY (INITIAL): PINK OWNER COPY (INITIAL): GOLD