IREDELL COUNTY HEALTH DEPARTMENT

Const. Auth (4:00) STATESVILLE 704-878-5305 MOORESVILLE 704-664-5281

IMPROVEMENT PERMIT / ~~CERTIFICATE OF COMPLETION~~ / OPERATION PERMIT / EXISTING SYSTEM INSPECTION

PROPERTY DESCRIPTION NO. 24655 DATE Oct 15, '97 TAX MAP NO. part of 1LA5 4658 31 3979 Watershed: ☑ Yes ☐ No

OWNER OR CONTRACTOR Krom Financial Services PHONE: Business 664-3671 Home WS II CA

ADDRESS 149 Yacht Cove Rd Mooresville

LOCATION 21 N. ~~TL~~ Valleymeer TR Brook-tree on left At end

SUBDIVISION Oakbrook BLOCK / SECTION LOT 76 LOT AREA 1.41 Ac SITE CLASS. B DESIGN FLOW 360 gpd L.T.A.R. N.3

Septic Tank: 1000 Gallons; STB 825 Date 1/14/98

Pump Tank: 1000 Gallons; PT 47 Date 1/14/98

Pump Make: ____ Model ____ Serial No. ____

Nitrification Field: No Fields 1 Square Feet 1200 Linear Feet 400

No Lines 4@100' Trench Width 36" Max Trench Bottom Depth 18" Gravel Depth 12"

☑ New System ☐ Repair System Type: I, II, III, IV, V, VI

System Description: pumped pressure shallow conventional

Repair System Description: same

Maintenance Agreement Required: ☐ Yes ☑ No

☑ House/Mod. Home No. Bedrooms 3

☐ Mobile Home No. Bathrooms 2

☐ Business No. Employees ____

☐ Other ____

☐ Slab ☑ Crawl Space ☐ Basement w/plumbing ☐ Basement wo/plumbing


Water Supply: ☑ Individual ☐ Community ☐ Public

Comments: Septic System installer note trench bottom depth (18")

Comments:

1"=100'

INITIAL SITE SKETCH

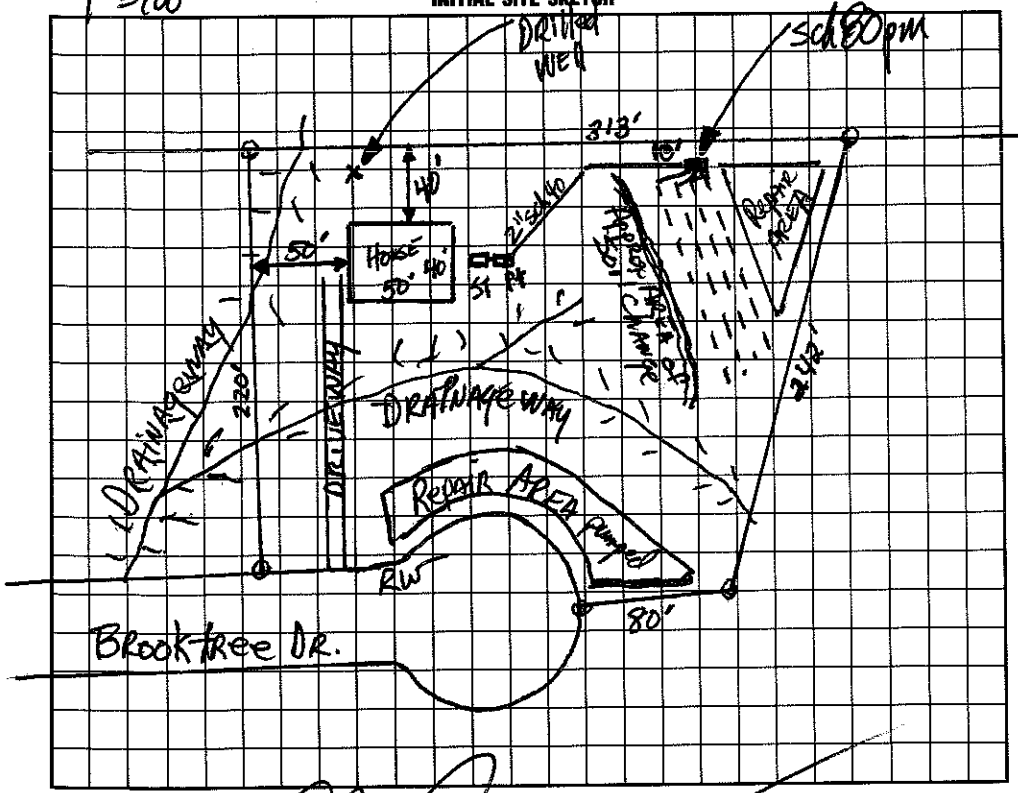

AS BUILT SKETCH

I understand that this permit can be suspended or revoked if any false information is supplied toward securing the permit/any unauthorized changes are made to the site/any unauthorized changes are made in the installation of the system. Improvement Permit is valid for 60 months from date of issuance.

Signed: ____

Improvement Permit by: ____ RS date 10-15-97

~~Construction~~ ~~Existing System~~ Inspection by: Authorization ____ RS date 10-15-97

Installed by: ROWAN SEPTIC

Certificate of Completion by: Wesley Sparks R.S. date 6/15/98

Operation Permit by: Wesley Sparks R.S. date 6/15/98

HEALTH DEPT. COPY: WHITE INSPECTION COPY (FINAL): GREEN OWNER COPY (FINAL): YELLOW INSPECTION COPY (INITIAL): PINK OWNER COPY (INITIAL): GOLD