(69841)

IREDELL COUNTY HEALTH DEPARTMENT Const. Auth STATESVILLE 704-878-5305 MOORESVILLE 704-664-5281

IMPROVEMENT PERMIT / ~~CERTIFICATE OF COMPLETION~~ / OPERATION PERMIT / EXISTING SYSTEM INSPE

PROPERTY DESCRIPTION NO. 24656 DATE Oct 15, '97 TAX MAP NO. part of 1LA5 4658 31 6906 Watershed: ☑ Yes ☐

OWNER OR CONTRACTOR Ryan Financial Services PHONE: Business 664-3671 Home

ADDRESS 149 Yacht Cove Rd Mooresville

LOCATION 21N. TL Valleyview TR Brooktree AT END

SUBDIVISION Oakbrook BLOCK / SECTION LOT 77 LOT AREA 1.33AC SITE CLASS PS DESIGN FLOW 360gpd L.T.A.R. .3

Septic Tank: 1000 Gallons; STB 825 Date 5/14/93

Pump Tank: 1000 Gallons; PT Date

Pump Make: Model Serial No.

Nitrification Field: No Fields 1 Square Feet 1200 Linear Feet 400

No Lines 4@100' Trench Width 36" Max Trench Bottom Depth 24" Gravel Depth 12"

☑ New System ☐ Repair System Type: I, II, (III) IV, V, VI

System Description: pumped pm conventional

Repair System Description: same

Maintenance Agreement Required: ☐ Yes ☑ No

☑ House/Mod. Home ☐ Mobile Home ☐ Business ☐ Other

No. Bedrooms 3 No. Bathrooms 2 No. Employees

☐ Slab ☑ Crawl Space ☐ Basement w/plumbing ☐ Basement wo/plumbing


Water Supply: ☑ Individual ☐ Community ☐ Public

Comments:


Comments: WELL NOT LOCATED AT TIME OF INSPECTION

1"=100'

INITIAL SITE SKETCH

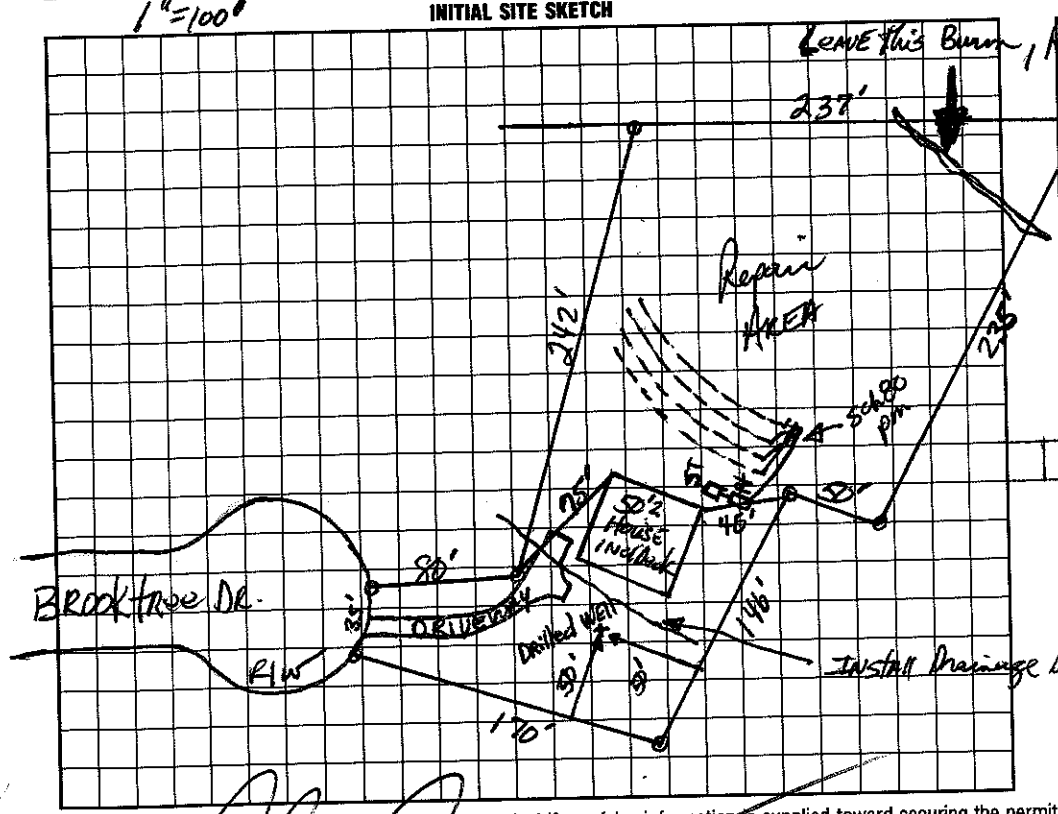

AS BUILT SKETCH

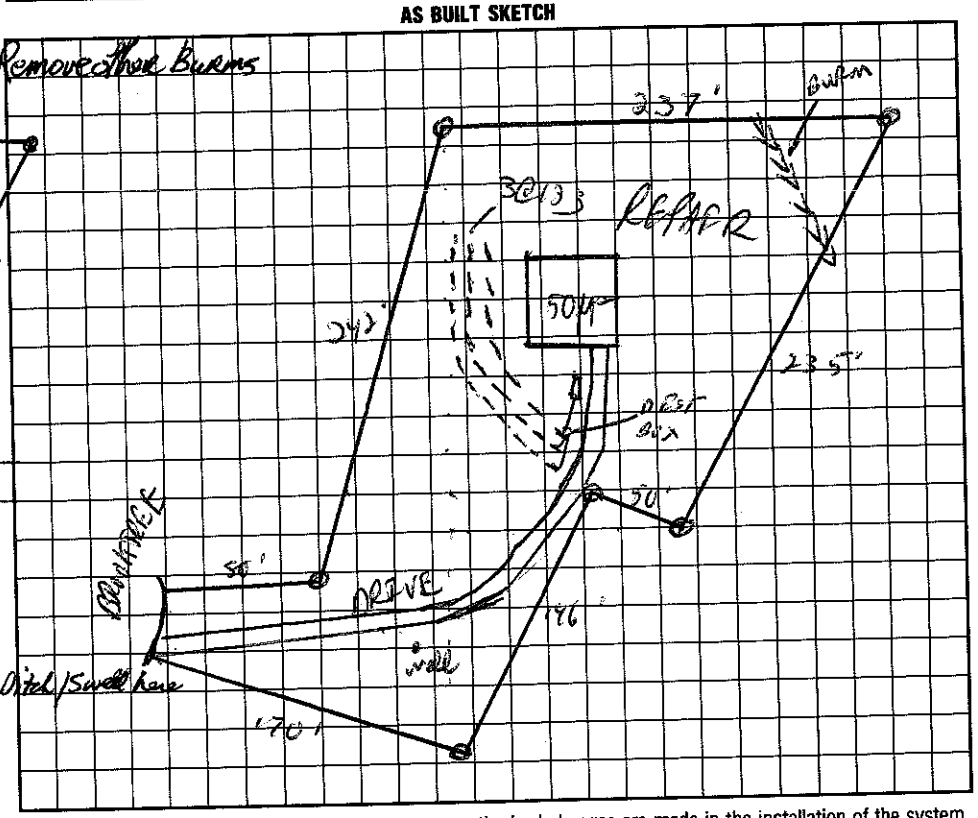

I understand that this permit can be suspended or revoked if any false information is supplied toward securing the permit/any unauthorized changes are made to the site/any unauthorized changes are made in the installation of the system. Improvement Permit is valid for 60 months from date of issuance.

Signed:

Improvement Permit by: RS date 10-15-97

~~Septic System Inspection by:~~ Construction Authorization RS date 10-15-97

Installed by: Rowan Septic

Certificate of Completion by: CS date

Operation Permit by: CS date 6/23/98

HEALTH DEPT. COPY: WHITE INSPECTION COPY (FINAL): GREEN OWNER COPY (FINAL): YELLOW INSPECTION COPY (INITIAL): PINK OWNER COPY (INITIAL): GOLD