(C: 30-4500)

IREDELL COUNTY HEALTH DEPARTMENT

Const. Auth. STATESVILLE 704-878-5305 MOORESVILLE 704-664-5281

IMPROVEMENT PERMIT / ~~CERTIFICATE OF COMPLETION~~ / OPERATION PERMIT / EXISTING SYSTEM INSPECTION

PROPERTY DESCRIPTION NO. 24654 DATE Sept. 10, 97 TAX MAP NO. part of 11A5 4658320051 Watershed: ☑ Yes ☐ No

OWNER OR CONTRACTOR Ryan Financial Services PHONE: Business _____ Home _____

ADDRESS 149 Yacht Cove Rd.

LOCATION 21 N. TR Valleyview TR Brooktree on left NEAR end

SUBDIVISION Oakbrook BLOCK / SECTION _____ LOT 75 LOT AREA .97Ac SITE CLASS. 2S DESIGN FLOW 360gpd L.T.A.R. ~.35

Septic Tank: 1000 Gallons; STB 823 Date 4/7/98

Pump Tank: 1000 Gallons; PT 71 Date 3/24/98

Pump Make: ZOELLER Model 11137-0 Serial No. 137-0002

Nitrification Field: No Fields 1 Square Feet 1440 Linear Feet 480

No Lines 4 @ 120' Trench Width 36" Max Trench Bottom Depth 18"

☑ New System ☐ Repair System Type: I, II, ☑ III, IV, V, VI

System Description: pumped-pressure shallow conventional

Repair System Description: same or LPP

Maintenance Agreement Required: ☐ Yes ☑ No

☑ House/Mod. Home No. Bedrooms 3

☐ Mobile Home No. Bathrooms 2

☐ Business No. Employees _____

☐ Other _____

☐ Public


☑ Slab ☑ Crawl Space ☐ Basement w/plumbing ☐ Basement wo/plumbing

Gravel Depth 12"

Comments: 47
43
31
27
1" = 100'

Comments: LINES, TANKS checked

INITIAL SITE SKETCH

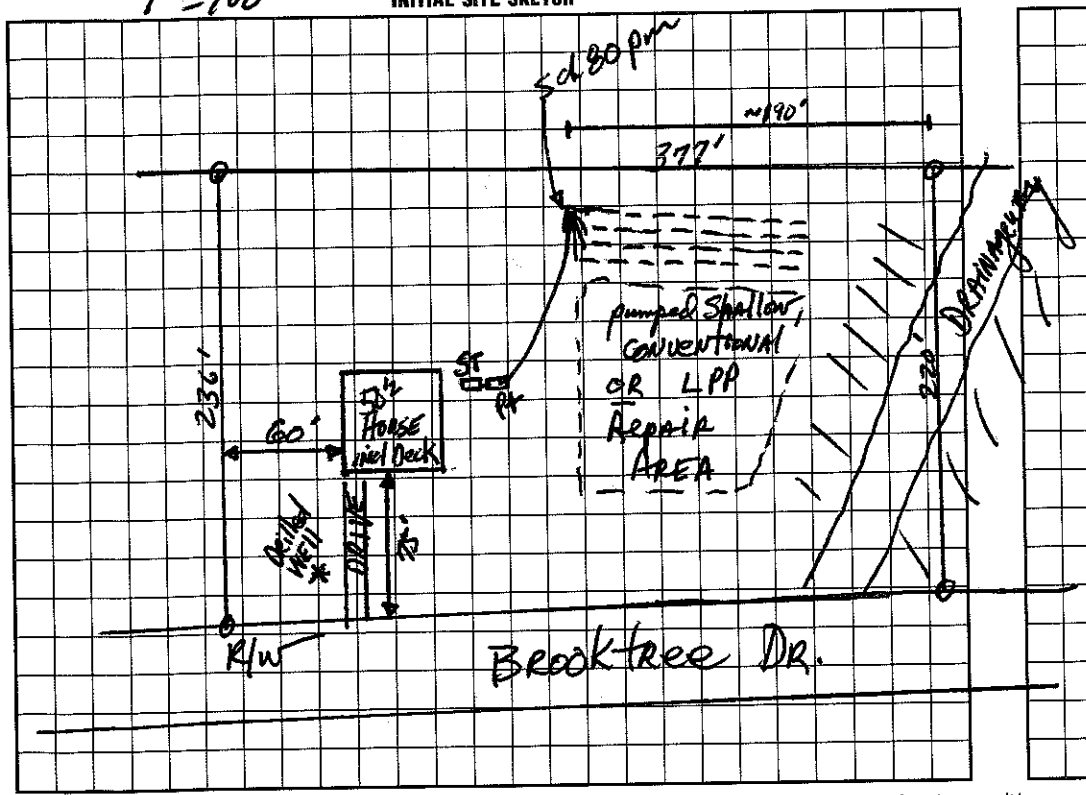

AS BUILT SKETCH

I understand that this permit can be suspended or revoked if any false information is supplied toward securing the permit/any unauthorized changes are made to the site/any unauthorized changes are made in the installation of the system. Improvement Permit is valid for 60 months from date of issuance.

Signed: _____

Improvement Permit by: _____ date 9-10-97

~~Construction~~ Authorization by: _____ date 9-10-97

Installed by: POWAY SEPTIC

Certificate of Completion by: _____ date _____

Operation Permit by: _____ date 4/14/98

HEALTH DEPT. COPY: WHITE INSPECTION COPY (FINAL): GREEN OWNER COPY (FINAL): YELLOW INSPECTION COPY (INITIAL): PINK OWNER COPY (INITIAL): GOLD