4658329135

# IREDELL COUNTY HEALTH DEPARTMENT

MOUTH TO CONSTRUCT

STATESVILLE 704-878-5305 MOORESVILLE 704-664-5281

## IMPROVEMENT PERMIT / ~~CERTIFICATE OF COMPLETION~~ / OPERATION PERMIT / EXISTING SYSTEM INSPECTION

PROPERTY DESCRIPTION NO. REPAIR DATE 11/6/96 TAX MAP NO. REPAIR Watershed: ☐ Yes ☐ No

OWNER OR CONTRACTOR HENRY PARKER PHONE: Business Home 664 1172

ADDRESS 2276 CHARLOTTE HWY.

LOCATION 21 N - # 2276 ON LEFT.

SUBDIVISION — BLOCK / SECTION — LOT — LOT AREA — SITE CLASS. PS DESIGN FLOW 270 GPD L.T.A.R. 2.3 GPD

Septic Tank: EXISTING Gallons; STB Date

Pump Tank: Gallons; PT Date

Pump Make: Model Serial No.

Nitrification Field: No Fields 1 Square Feet 450 Linear Feet 150

No Lines 3 Trench Width ~~AS NEEDED~~ 36" Max Trench Bottom Depth AS NEEDED Gravel Depth 12"

☑ New System ☐ Repair System Type: I, II, III, IV, V, VI

System Description: GRAVITY 90 NV.

Repair System Description:

Maintenance Agreement Required: ☐ Yes ☑ No

☑ House/Mod. Home No. Bedrooms 2

☐ Mobile Home No. Bathrooms 2

☐ Business No. Employees

☐ Other


☐ Slab ☑ Crawl Space ☐ Basement w/plumbing ☐ Basement wo/plumbing

Water Supply: ☑ Individual ☐ Community ☐ Public

Comments:

Comments:

**INITIAL SITE SKETCH**

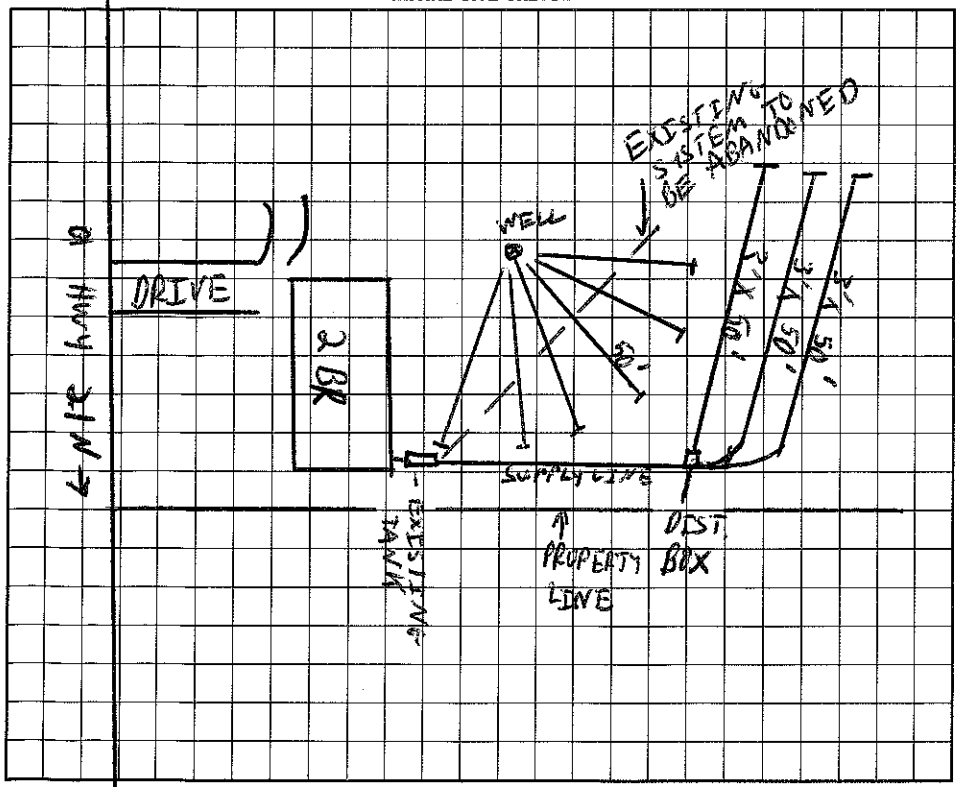


**AS BUILT SKETCH**

I understand that this permit can be suspended or revoked if any false information is supplied toward securing the permit/any unauthorized changes are made to the site/any unauthorized changes are made in the installation of the system.

Signed: Henry Parker

Improvement Permit by: C. Kelly Teem EHSI date 11/6/96

Existing System Inspection by: C. Kelly Teem EHSI date 11/6/96

Installed by: LARRY BEAM

Certificate of Completion by: date

Operation Permit by: C. Kelly Teem date 11/13/96

HEALTH DEPT. COPY: WHITE INSPECTION COPY (FINAL): GREEN OWNER COPY (FINAL): YELLOW INSPECTION COPY (INITIAL): PINK OWNER COPY (INITIAL): GOLD