IREDELL COUNTY HEALTH DEPARTMENT

Existing System

STATESVILLE 704-878-5305 MOORESVILLE 704-664-5281

IMPROVEMENT PERMIT / AUTHORIZATION TO CONSTRUCT / OPERATION PERMIT / EXISTING SYSTEM INSPECTION

PERMIT# 146981 PIN# 4658344333.000

OWNER OR CONTRACTOR Joe Nantz DATE 12/7/07

ADDRESS 199 Cornelius Rd Mooresville NC 28117 PHONE: Business 704 664-2713 Home

LOCATION Hwy 21 N TL on Cornelius Rd TL Indian Springs Dr. 2nd Lot on Left

SUBDIVISION N/A BLOCK / SECTION LOT LOT AREA ≈.5 acre SITE CLASS P5 DESIGN FLOW ~~360~~ 410 AC 12/12/07 L.T.A.R.

Septic Tank: 1000 Exis Gallons: STB Exis Date

Pump Tank: Gallons: PT Date

Pump Make: Model Serial No. Existing

Nitrification Field: No Fields 1 Square Feet ≈ 750' Linear Feet ≈ 250 Ft

No Lines 3 Exis Trench Width 36" Max Trench Bottom Depth Exis Gravel Depth Exis

☐ New System ☐ Repair System Type: I, II, III, IV, V, VI

System Description: Existing System

Repair System Description:

Maintenance Agreement Required: ☐ Yes ☐ No

☐ House/Mod. Home No. Bedrooms 3

☑ Mobile Home No. Bathrooms

☐ Business No. Employees

☐ Other


☐ Slab ☑ Crawl Space ☐ Basement w/plumbing ☐ Basement wo/plumbing

Water Supply: ☑ Individual ☐ Public ☐ Community


Comments:/Conditions:

Comments:/Conditions: Home must be placed as shown to stay 5' from the drainfield. No visible malfunction observed of Existing septic system. 3 Bedroom home to be placed on Lot.

INITIAL SITE SKETCH

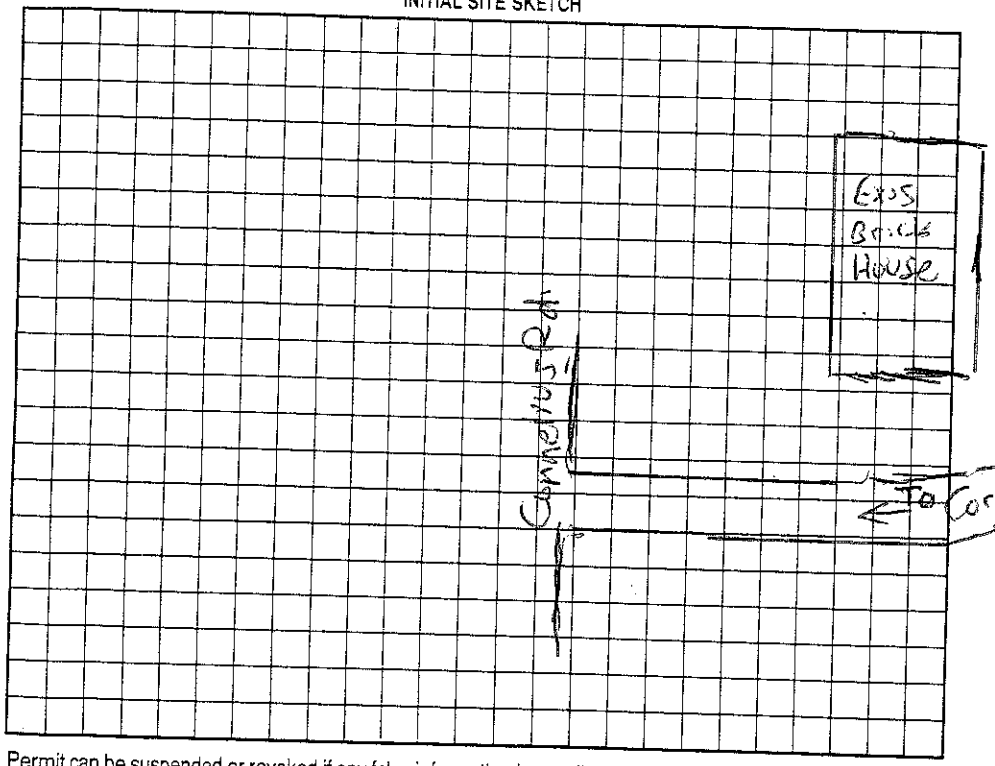

AS BUILT SKETCH P'line 1"=50'

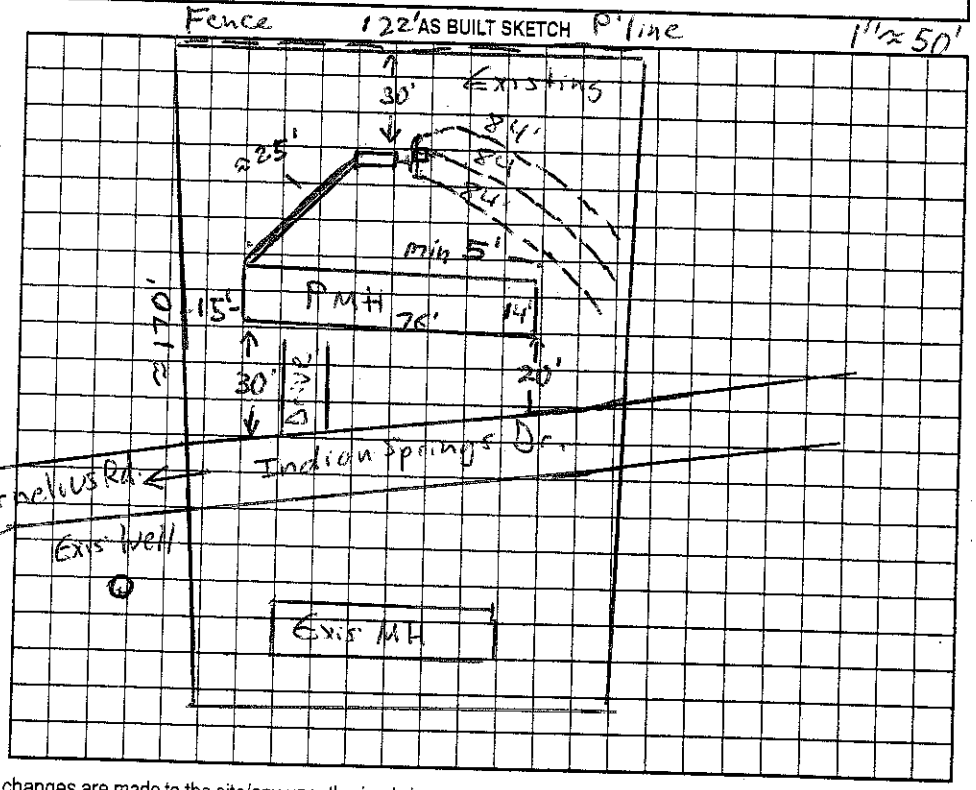

Permit can be suspended or revoked if any false information is supplied toward securing the permit/any unauthorized changes are made to the site/any unauthorized changes are made in the installation of the system. Improvement Permit with plat valid without expiration. Improvement Permit with site plan valid for sixty months. Authorization to Construct is valid for a period equal to that of Improvement Permit – not to exceed sixty months.

Signed: Joe V Nantz date 12-12-07 Installed by:

Improvement Permit by: date Operation Permit by: date

Authorization to Construct by: date Existing System Inspection by: Anthony Coker Jr. date 12/7/07

HEALTH DEPT. COPY: WHITE OWNER COPY (FINAL): YELLOW OWNER COPY (INITIAL): PINK