IREDELL COUNTY HEALTH DEPARTMENT

STATESVILLE 704-878-5305
MOORESVILLE 704-664-5281

4658364145

IMPROVEMENT PERMIT / CERTIFICATE OF COMPLETION / OPERATION PERMIT / EXISTING SYSTEM INSPECTION


PROPERTY DESCRIPTION NO. 15775 DATE 10/5/93
OWNER OR CONTRACTOR FRANKLIN T SMITH TAX MAP NO. 1R A 15A
ADDRESS BAILEY RD. MOORESVILLE, NC, 28115 PHONE: Business Home 663-2096
LOCATION BAILEY RD; 2 INTL ON BAILEY RD. ~ .5 MI ON (L) DOWN DRIVE ON (R)
SUBDIVISION BLOCK / SECTION LOT LOT AREA SITE CLASS. L.T.A.R. .3-.35

Water Supply: ☑ Individual ☐ Community ☐ Public [ACROSS ROAD]
Septic Tank: 1000 Gallons; STB 358 Date 9/1/93
Pump Tank: Gallons; PT Date
Nitrification Field: No Fields 1 Square Feet 1200 Linear Feet 400
No Lines 4 Trench Width 3' Trench Depth 32" Gravel Depth 12"
☑ New System ☐ Repair System Type: I, (II), III, IV, V, VI
System Description: CONV - DIST. BOX
Repair System Description:
Maintenance Agreement Required: ☐ Yes ☑ No


☑ House/Mod. Home No. Bedrooms 3
☐ Mobile Home No. Bathrooms 2.5
☐ Business No. Employees
☐ Other
Garbage Disposal: ☐ Yes ☑ No
Auto. Dishwasher: ☑ Yes ☐ No
Auto. Washing Machine: ☑ Yes ☐ No
Other
☐ Slab ☑ Crawl Space ☐ Basement w/plumbing ☐ Basement wo/plumbing

Comments

INITIAL SITE SKETCH

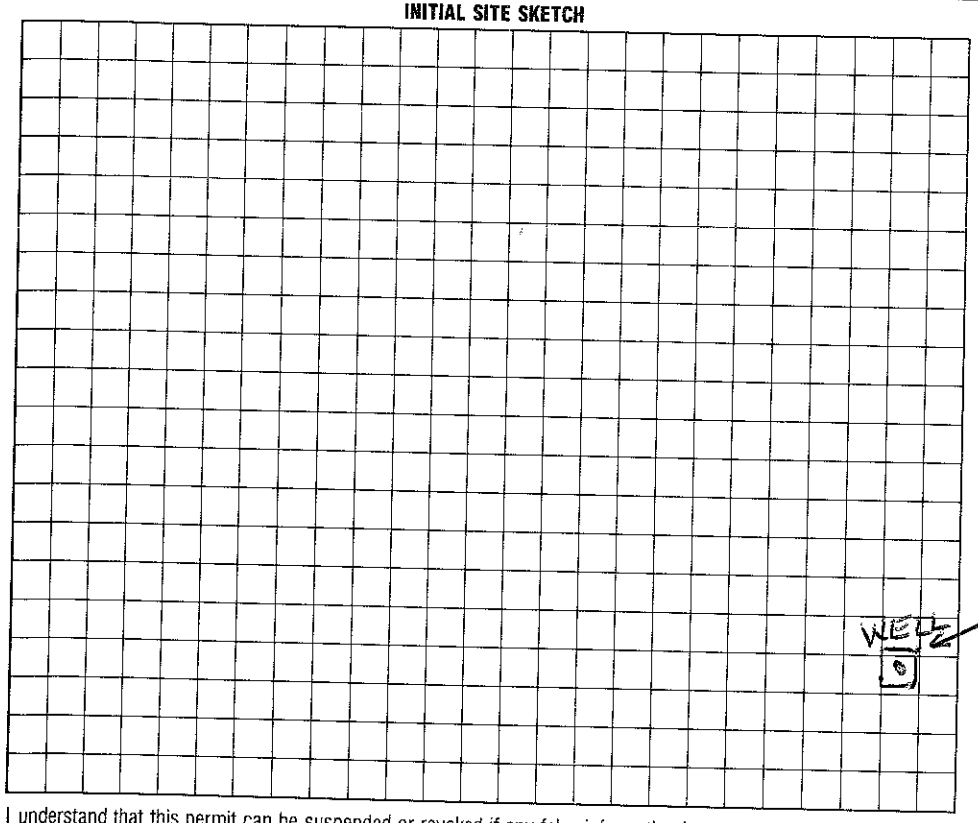

AS BUILT SKETCH

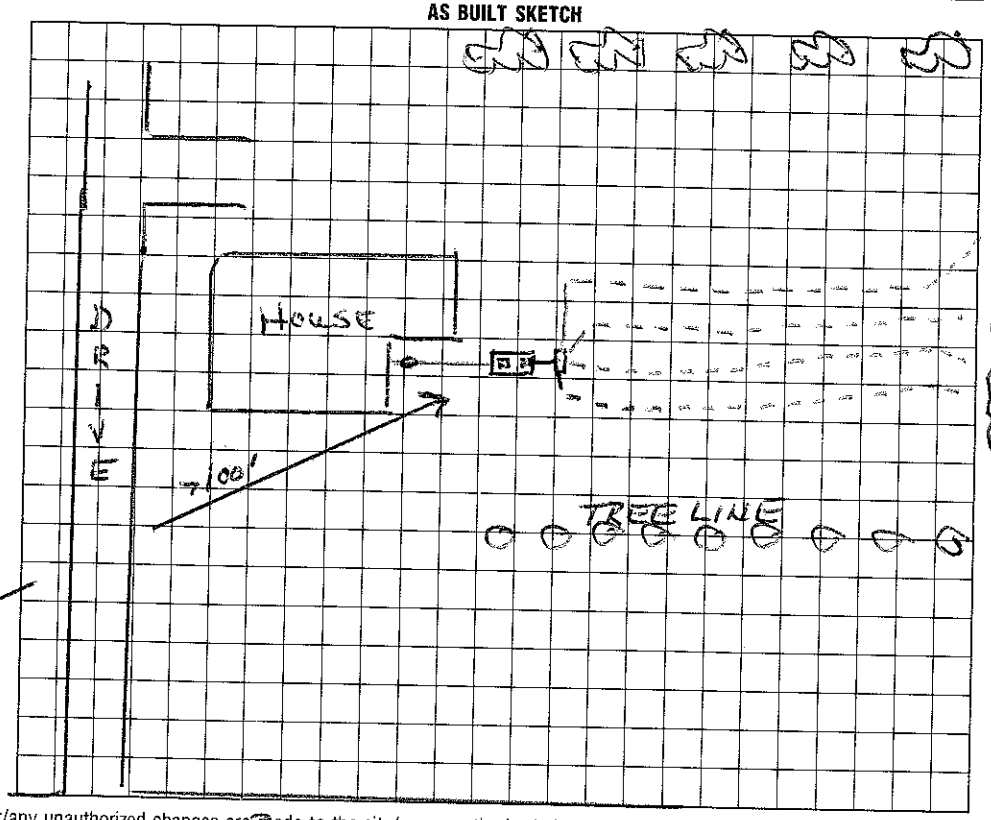

I understand that this permit can be suspended or revoked if any false information is supplied toward securing the permit/any unauthorized changes are made to the site/any unauthorized changes are made in the installation of the system. Improvement Permit is valid for 60 months from date of issuance.

Signed:

Improvement Permit by: date

Existing System Inspection by: date

Installed by: FT ERVIN

Certificate of Completion by: Wesley Sparks RS date 10/5/93

Operation Permit by: date

HEALTH DEPT. COPY: WHITE INSPECTION COPY (FINAL): GREEN OWNER COPY (FINAL): YELLOW INSPECTION COPY (INITIAL): PINK OWNER COPY (INITIAL): GOLD