# IREDELL COUNTY HEALTH DEPARTMENT

STATESVILLE 704-878-5305 MOORESVILLE 704-664-5281

## IMPROVEMENT PERMIT / CERTIFICATE OF COMPLETION / OPERATION PERMIT / EXISTING SYSTEM INSPECTION

Application to Construct

4658 37 0465

PROPERTY DESCRIPTION NO. 23147 DATE 5/2/96

OWNER OR CONTRACTOR Tommy G. Hendrix TAX MAP NO. IR A 46

ADDRESS 292 Bailey Rd. Mooresville, NC. 28115 PHONE: Business 663-5151 Home Watershed: [X] Yes [ ] No

LOCATION 21N TL Bailey Rd. TR Kelsey Ln. ~ 400 feet on (L)

SUBDIVISION TG Hendrix BLOCK / SECTION LOT 2 LOT AREA .59 Ac SITE CLASS PS DESIGN FLOW 360 L.T.A.R. .3

Septic Tank: 1000 Gallons; STB 825 Date 3/11/96

Pump Tank: Gallons; PT Date

Pump Make: Model Serial No.

Nitrification Field: No Fields 1 Square Feet 1200 Linear Feet ~~400~~

No Lines 5 Trench Width 36" Max Trench Bottom Depth 36" Gravel Depth ~~Same~~ 12"

[X] New System [ ] Repair System Type: I. II. III. IV. V. VI

System Description: ~~Chamber~~ CONVENTIONAL

Repair System Description: Same

Maintenance Agreement Required: [ ] Yes [X] No

[ ] House/Mod. Home No. Bedrooms 3

[X] Mobile Home No. Bathrooms 2

[ ] Business No. Employees

[ ] Other


[ ] Slab [X] Crawl Space [ ] Basement w/plumbing [ ] Basement wo/plumbing

Water Supply: [X] Individual [ ] Community [ ] Public Hendrix


Comments: Drop Boxes —

Comments: Lines were installed over weekend. Heavy rains filled trenches ~~feet~~ water damage is possible.

INITIAL SITE SKETCH

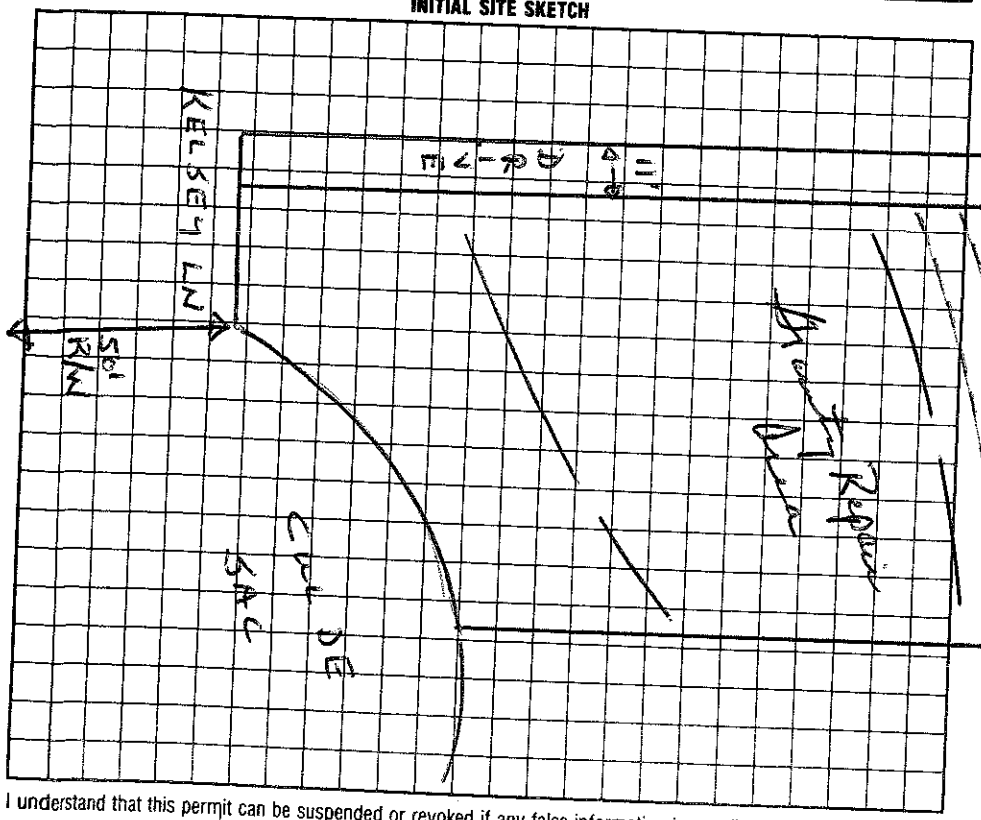


AS BUILT SKETCH

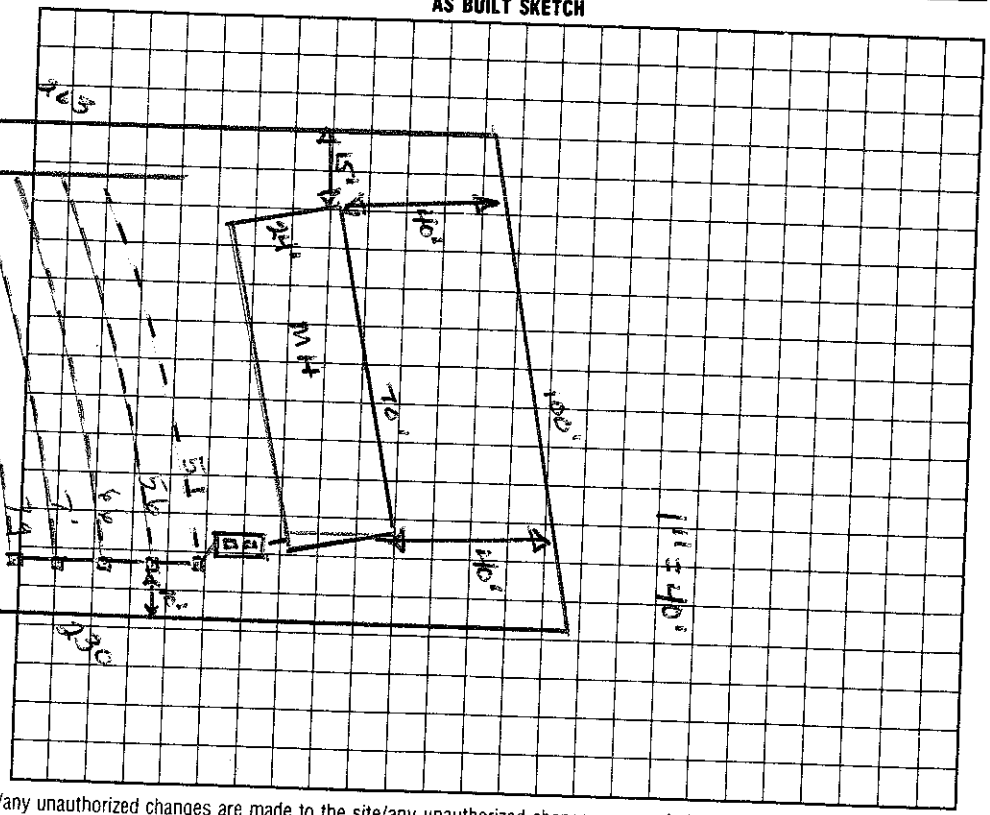


I understand that this permit can be suspended or revoked if any false information is supplied toward securing the permit/any unauthorized changes are made to the site/any unauthorized changes are made in the installation of the system.

Signed: ~~X~~ Vickie Hendrix

Improvement Permit by: Wesley Sparks R.S. date 5/2/96

~~Existing system inspection by:~~ Construct Wesley Sparks R.S. date 5/2/96

Installed by: Foster Pool Co.

Certificate of Completion by: date

Operation Permit by: C. Peck Freeman EH S.I. date 6/10/96

HEALTH DEPT. COPY: WHITE INSPECTION COPY (FINAL): GREEN OWNER COPY (FINAL): YELLOW INSPECTION COPY (INITIAL): PINK OWNER COPY (INITIAL): GOLD