IREDELL COUNTY HEALTH DEPARTMENT

Authorization to Construct

4658 370575

STATESVILLE 704-878-5305 MOORESVILLE 704-664-5281

IMPROVEMENT PERMIT / ~~CERTIFICATE OF COMPLETION~~ / OPERATION PERMIT / EXISTING SYSTEM INSPECTION

PROPERTY DESCRIPTION NO. 23146 DATE 5/2/96 TAX MAP NO. IRA 46 Watershed: [X] Yes [ ] No

OWNER OR CONTRACTOR Tommy S. Hendrix PHONE: Business 663-5151 Home

ADDRESS 292 Baily Rd. Mooresville, NC. 28115

LOCATION 21N To Bailey Rd. TR Kelsey Ln. ~ 500' to lot on (L)

SUBDIVISION TS Hendrix BLOCK / SECTION LOT 3 LOT AREA .51 AC SITE CLASS PS DESIGN FLOW 360 L.T.A.R. .3

Septic Tank: 1000 Gallons; STB 825 Date 3/10/96
Pump Tank: Gallons; PT Date
Pump Make: Model Serial No.
Nitrification Field: No Fields 1 Square Feet 1200 Linear Feet 400
No Lines 4 Trench Width 36" Max Trench Bottom Depth 36" Gravel Depth 12"

[X] New System [ ] Repair System Type: I, [II], III, IV, V, VI
System Description: Conventional
Repair System Description: Same
Maintenance Agreement Required: [ ] Yes [X] No


[ ] House/Mod. Home No. Bedrooms 3
[X] Mobile Home No. Bathrooms 2
[ ] Business No. Employees
[ ] Other
[ ] Slab [X] Crawl Space [ ] Basement w/plumbing [ ] Basement wo/plumbing

Water Supply: [X] Individual [ ] Community [ ] Public
Lower


Comments:

Comments: Water damage is possible from trenches being rained in.

INITIAL SITE SKETCH

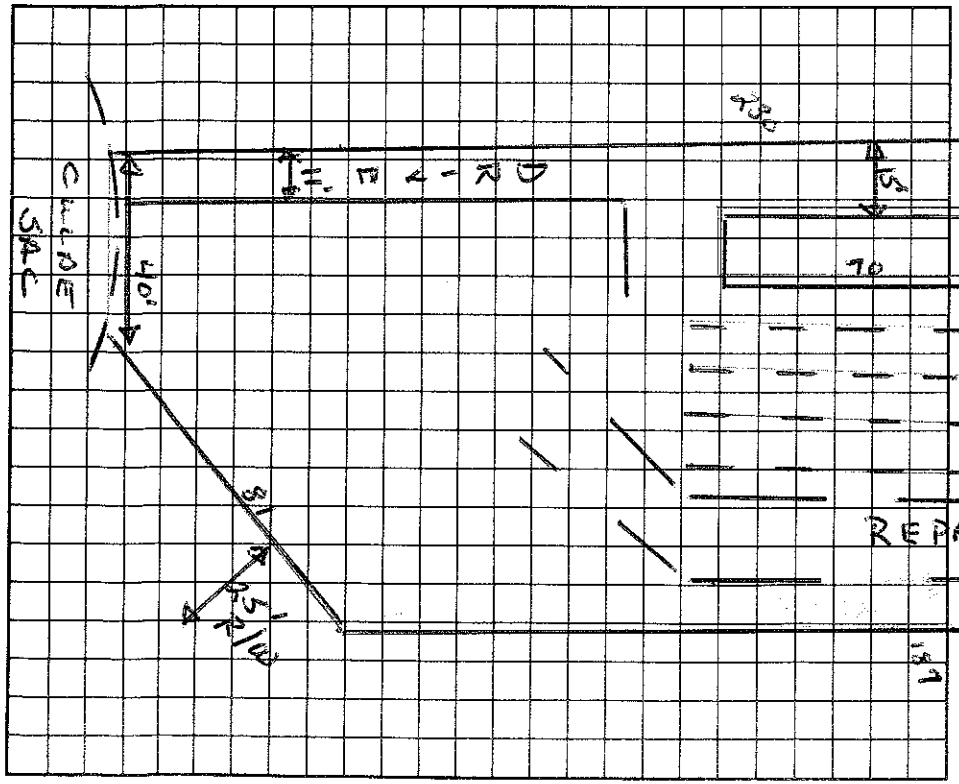

AS BUILT SKETCH

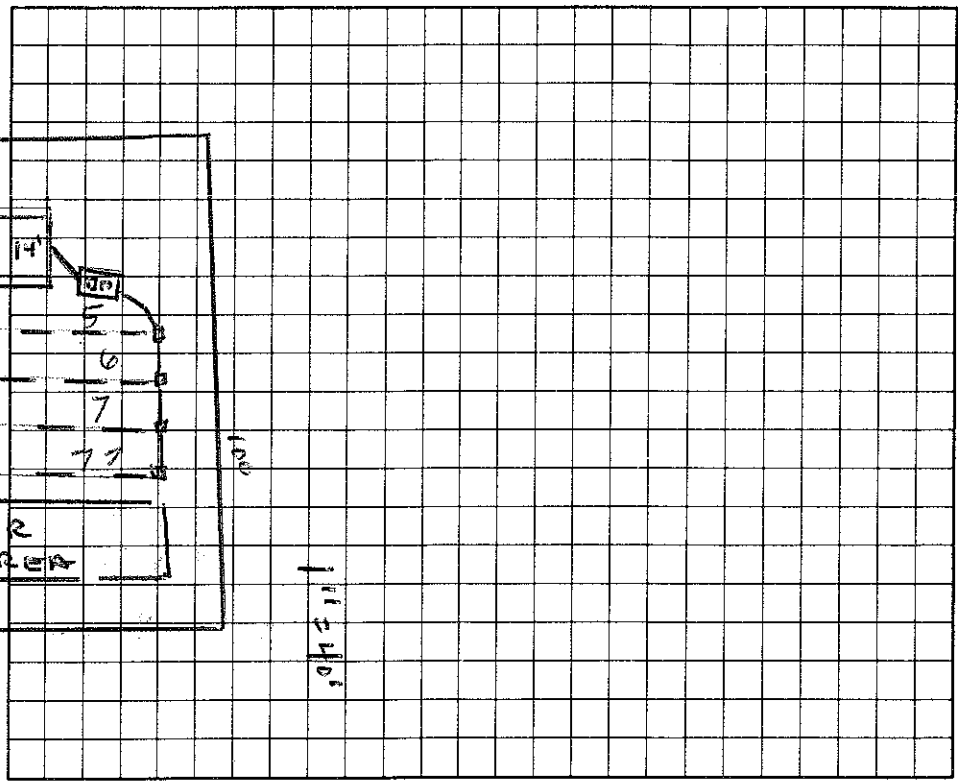

I understand that this permit can be suspended or revoked if any false information is supplied toward securing the permit/any unauthorized changes are made to the site/any unauthorized changes are made in the installation of the system.

Signed: Vicki Hendrix

Improvement Permit by: Wesley Sparkes date 5/2/96

Authorization to Construct Existing system inspection by: Wesley Sparkes date 5/2/96

Installed by: Foster Pool Co.

Certificate of Completion by: date

Operation Permit by: [illegible] date 6/10/96

HEALTH DEPT. COPY: WHITE INSPECTION COPY (FINAL): GREEN OWNER COPY (FINAL): YELLOW INSPECTION COPY (INITIAL): PINK OWNER COPY (INITIAL): GOLD