IREDELL COUNTY HEALTH DEPARTMENT

Authorization to Construct

4658373836

STATESVILLE 704-878-5305 MOORESVILLE 704-664-5281

IMPROVEMENT PERMIT / ~~CERTIFICATE OF COMPLETION~~ / OPERATION PERMIT / EXISTING SYSTEM INSPECTION

PROPERTY DESCRIPTION NO. 23145 DATE 4/30/96 TAX MAP NO. Pt of IR A 46 Watershed: [X] Yes [ ] No

OWNER OR CONTRACTOR Tommy G Hendrix PHONE: Business 663-5151 Home

ADDRESS 292 Bailey Rd Mooresville, NC 28115

LOCATION 21 N TL Bailey Rd. TR Kelsey Ln. bear (R) to end of drive 240

SUBDIVISION TG Hendrix BLOCK / SECTION LOT 6 LOT AREA 1.16Ac SITE CLASS. PS DESIGN FLOW ~~360~~ 330 L.T.A.R. .3 .295

Septic Tank: 1000 Gallons; STB ~~825~~ Date 10/12/97

Pump Tank: Gallons; PT Date

Pump Make: Model 600 Serial No. 267

Nitrification Field: No Fields 1 Square Feet ~~330~~ Linear Feet ~~400~~

No Lines 3 Trench Width 36" Max Trench Bottom Depth 36" Gravel Depth 12"

[X] New System [ ] Repair System Type: I. II. III. IV. V. VI

System Description: Low-Conventional

Repair System Description: Same

Maintenance Agreement Required: [ ] Yes [X] No

[X] House/Mod. Home No. Bedrooms ~~3~~ 2 RED

[ ] Mobile Home No. Bathrooms 2

[ ] Business No. Employees

[ ] Other

[ ] Slab [X] Crawl Space [ ] Basement w/plumbing [ ] Basement wo/plumbing

Water Supply: [X] Individual [ ] Community [ ] Public


LOT 5

Comments: May change to 3 lines 88'+3' of Ch. Plastic drainfield material - AWS 10/28/97


Changes approved for chop loops and CH-Plastic drainfield area - AWS

Comments:

INITIAL SITE SKETCH

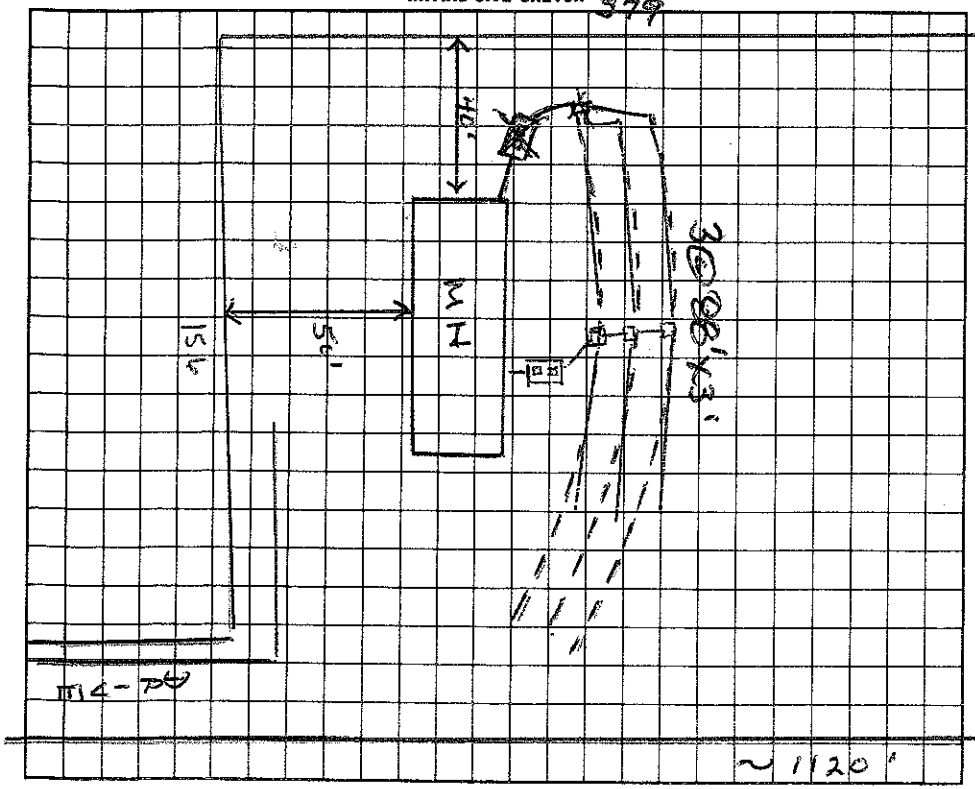

AS BUILT SKETCH

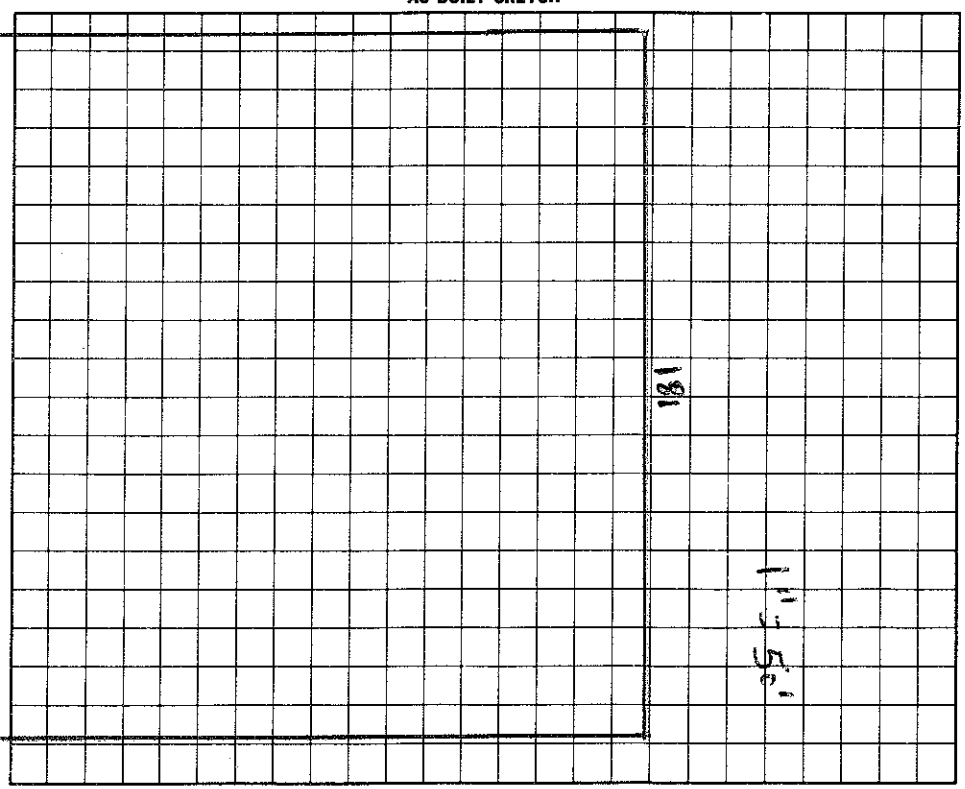

I understand that this permit can be suspended or revoked if any false information is supplied toward securing the permit/any unauthorized changes are made to the site/any unauthorized changes are made in the installation of the system.

Signed: Vicki Hendrix

Improvement Permit by: Wesley Sparks RS. date 5/2/96

Authorization to Construct Existing System Inspection by: Wesley Sparks RS. date 5/2/96

Installed by: Foster Pool Co

Certificate of Completion by: Wesley Sparks RS date 11/21/97

Operation Permit by: Wesley Sparks RS date 11/24/97

HEALTH DEPT. COPY: WHITE INSPECTION COPY (FINAL): GREEN OWNER COPY (FINAL): YELLOW INSPECTION COPY (INITIAL): PINK OWNER COPY (INITIAL): GOLD