10:00

# IREDELL COUNTY HEALTH DEPARTMENT

STATESVILLE 704-878-5305 MOORESVILLE 704-664-5281

## IMPROVEMENT PERMIT / AUTHORIZATION TO CONSTRUCT / OPERATION PERMIT / EXISTING SYSTEM INSPECTION

PERMIT# 072868 PIN# 4658 37 7844 DATE 4/29/98

OWNER OR CONTRACTOR Rhonda Campbell PHONE: Business Home 664-3550

ADDRESS 166 Leslie Loop Mooresville, NC. 28115

LOCATION 2IN TL Bailey Rd. TR Toucan Rd. TL Gold Finch Lane, straight off cul de sac

SUBDIVISION Farmdale BLOCK / SECTION TI LOT 16 LOT AREA .9 Ac SITE CLASS. PS DESIGN FLOW 360 L.T.A.R. .25

Septic Tank: 1000 Gallons; STB 1012 Date 8/11/98
Pump Tank: Gallons; PT Date
Pump Make: Model Serial No.
Nitrification Field: No Fields 1 Square Feet 1125 Linear Feet 375
No Lines 5 Trench Width 36" Max Trench Bottom Depth 32" Gravel Depth SAND.

[X] New System [ ] Repair System Type: I, II, (III), IV, V, VI
System Description: EGAV - CH PLASTIC
Repair System Description: SAME
Maintenance Agreement Required: [ ] Yes [X] No


[X] House/Mod. Home No. Bedrooms 3
[ ] Mobile Home No. Bathrooms 2
[ ] Business No. Employees
[ ] Other
[ ] Slab [ ] Crawl Space [X] Basement w/plumbing [ ] Basement wo/plumbing

Water Supply: [X] Individual [ ] Public [ ] Community


Comments:/Conditions:

Comments:/Conditions:

INITIAL SITE SKETCH (1" = 50')

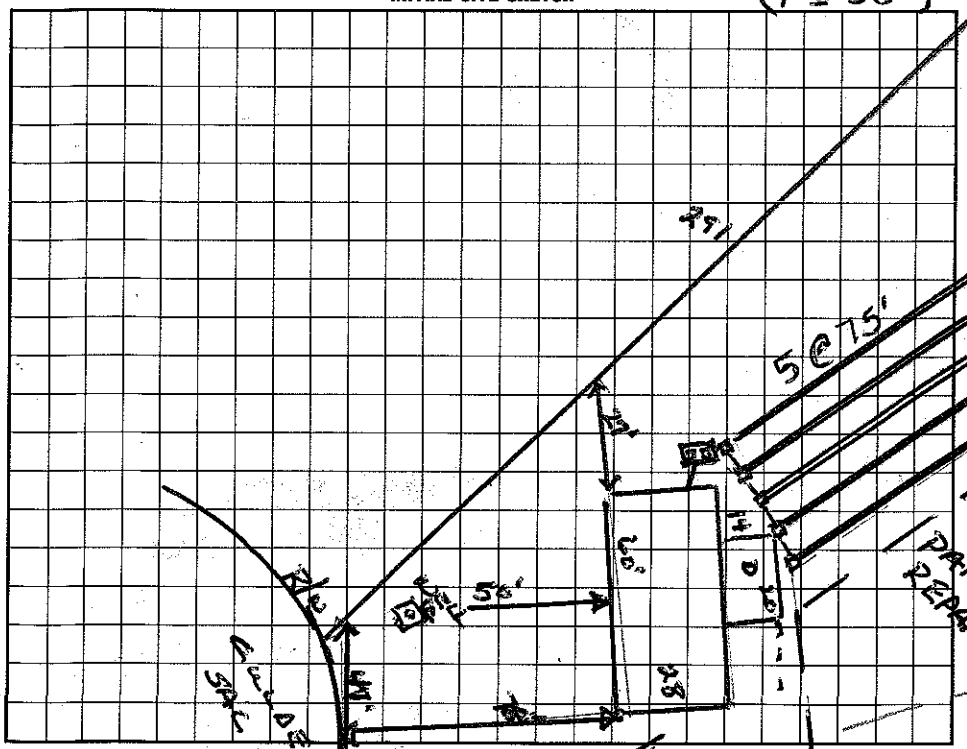


AS BUILT SKETCH

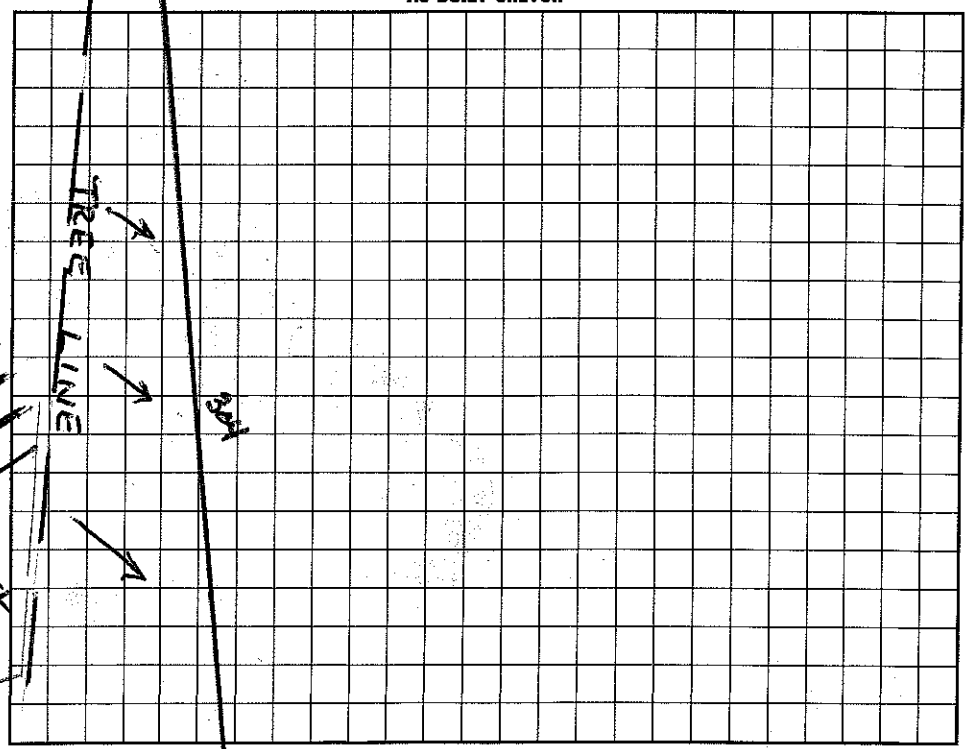


I understand that this permit can be suspended or revoked if any false information is supplied toward securing the permit/any unauthorized changes are made to the site/any unauthorized changes are made in the installation of the system. Improvement Permit with plat valid without expiration. Improvement Permit with site plan valid for sixty months. Authorization to Construct is valid for a period equal to that of Improvement Permit – not to exceed sixty months.

Signed: X Ruth Campbell date 8/11/98

Improvement Permit by: Wesley Sparks 25244 date 4/29/98

Authorization to Construct by: Wesley Sparks RS, date 4/29/98

Installed by: FOREST STAFORD

Operation Permit by: C. [signature] date 10/14/98

Existing System Inspection by: date

HEALTH DEPT. COPY: WHITE INSPECTION COPY (FINAL): GREEN OWNER COPY (FINAL): YELLOW INSPECTION COPY (INITIAL): PINK OWNER COPY (INITIAL): GOLD