IREDELL COUNTY HEALTH DEPARTMENT

(1:00 - 1:30)

STATESVILLE 704-878-5305 MOORESVILLE 704-664-5281

IMPROVEMENT PERMIT / AUTHORIZATION TO CONSTRUCT / OPERATION PERMIT / EXISTING SYSTEM INSPECTION

PERMIT# 073233 PIN# 4658 37 8596 DATE 4/22/98

OWNER OR CONTRACTOR Bill Hunter PHONE: Business _____ Home 664-8088

ADDRESS 626 Heatherly Drive Mooresville, NC 28115

LOCATION 21N To Bailey Rd TR Towerview Road TL Wren Lane on (R) side of cul de sac - 108 WREN LANE

SUBDIVISION Farmdale BLOCK / SECTION 7I LOT 20 LOT AREA .60 SITE CLASS PS DESIGN FLOW 360 L.T.A.R. .3

Septic Tank: 1000 Gallons; STB 1012 Date 5/19/98
Pump Tank: _____ Gallons; PT _____ Date _____
Pump Make: _____ Model _____ Serial No. _____
Nitrification Field: No Fields 1 Square Feet 900± Linear Feet 300±
No Lines 3 Trench Width 36" Max Trench Bottom Depth 36" Gravel Depth SAND.

[X] New System ☐ Repair System Type: I, II, (III), IV, V, VI
System Description: Biotech Plastic
Repair System Description: Same. 16" PPBS
Maintenance Agreement Required: ☐ Yes [X] No


[X] House/Mod. Home No. Bedrooms 3
☐ Mobile Home No. Bathrooms 2
☐ Business No. Employees _____
☐ Other _____

☐ Slab [X] Crawl Space ☐ Basement w/plumbing ☐ Basement wo/plumbing

Water Supply: [X] Individual ☐ Public ☐ Community


Comments:/Conditions:

INITIAL SITE SKETCH

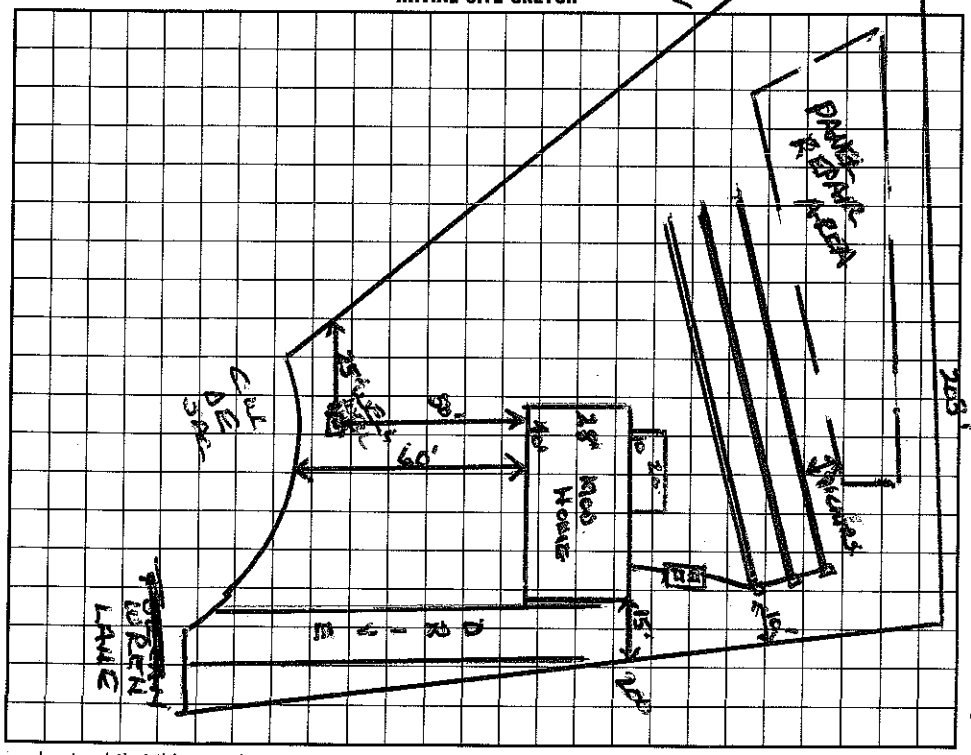

Comments:/Conditions: Wellmaton site 7/22/98 - AWS

AS-BUILT SKETCH

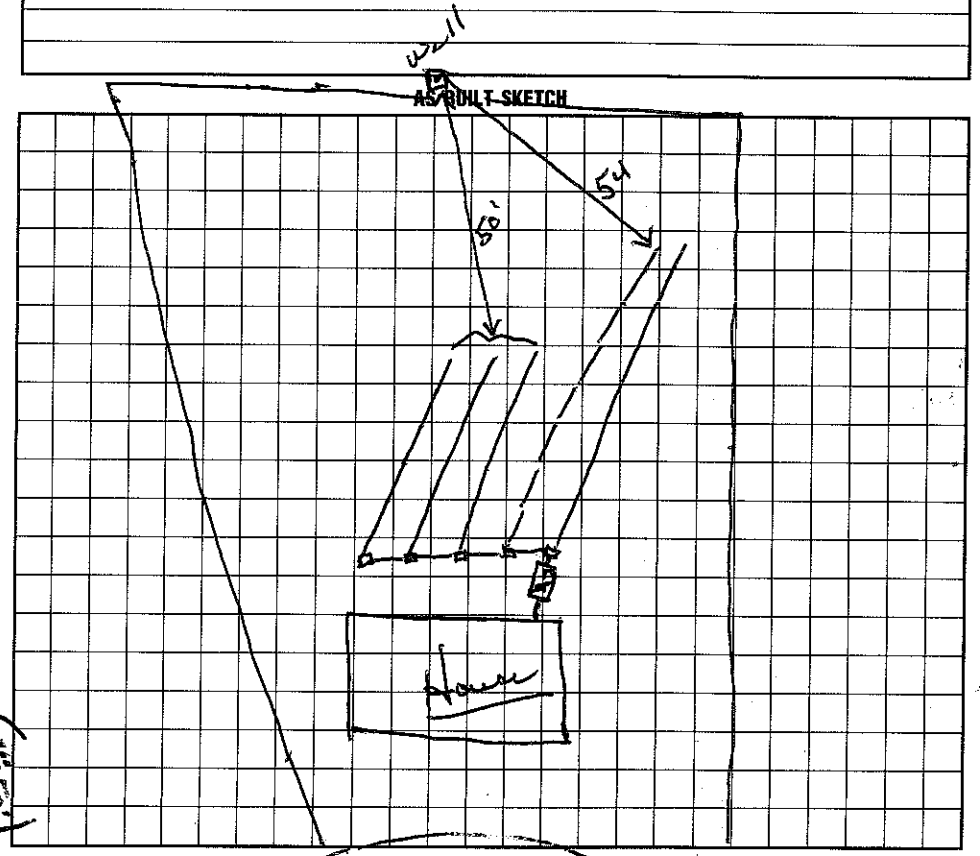

(1" = 50')

I understand that this permit can be suspended or revoked if any false information is supplied toward securing the permit/any unauthorized changes are made to the site/any unauthorized changes are made in the installation of the system. Improvement Permit with plat valid without expiration. Improvement Permit with site plan valid for sixty months. Authorization to Construct is valid for a period equal to that of Improvement Permit – not to exceed sixty months.

Signed: * _____ date 4/24/98 Installed by: Forest Shuford

Improvement Permit by: Wesley Sparks RS. date 4/23/98 Operation Permit by: Wesley Sparks RS. date 7/22/98

Authorization to Construct by: Wesley Sparks RS. date 4/23/98 Existing System Inspection by: Wesley Sparks RS. date 7/22/98

HEALTH DEPT. COPY: WHITE INSPECTION COPY (FINAL): GREEN OWNER COPY (FINAL): YELLOW INSPECTION COPY (INITIAL): PINK OWNER COPY (INITIAL): GOLD