IREDELL COUNTY HEALTH DEPARTMENT

STATESVILLE 704-878-5305 MOORESVILLE 704-664-5281

(1100)

IMPROVEMENT PERMIT / AUTHORIZATION TO CONSTRUCT / OPERATION PERMIT / EXISTING SYSTEM INSPECTION

PERMIT# 78311 PIN# 4658379381 DATE 4/19/99

OWNER OR CONTRACTOR CIRCLE B. CONST. PHONE: Business Home

ADDRESS 1042 N. MAIN ST. MOORESVILLE

LOCATION 21 N. TL BAILEY RD TR TOUCAN TL WREN IN CUL D'SAC

SUBDIVISION FARMDALE BLOCK / SECTION LOT 23 LOT AREA .68AC SITE CLASS. PS DESIGN FLOW 360 L.T.A.R. .3

Septic Tank: 1000 Gallons; STB 1012 Date 7/19/99

Pump Tank: 1000 Gallons; PT Date

Pump Make: HYDROMATIC Model SITE 50A Serial No. 8/99

Nitrification Field: No Fields 1 Square Feet 900 Linear Feet 300

No Lines 4@75' Trench Width 36" Max Trench Bottom Depth 36" Gravel Depth NA

☒ New System ☐ Repair System Type: I, II, (III), IV, V, VI

System Description: PUMP 25% REDUCTION

Repair System Description: SAME

Maintenance Agreement Required: ☐ Yes ☒ No

☒ House/Mod. Home No. Bedrooms 3

☐ Mobile Home No. Bathrooms 2

☐ Business No. Employees

☐ Other


☐ Slab ☒ Crawl Space ☐ Basement w/plumbing ☐ Basement wo/plumbing

Water Supply: ☒ Individual ☐ Public ☐ Community

Comments:/Conditions: POLYLOK

Comments:/Conditions:

INITIAL SITE SKETCH NOT TO SCALE

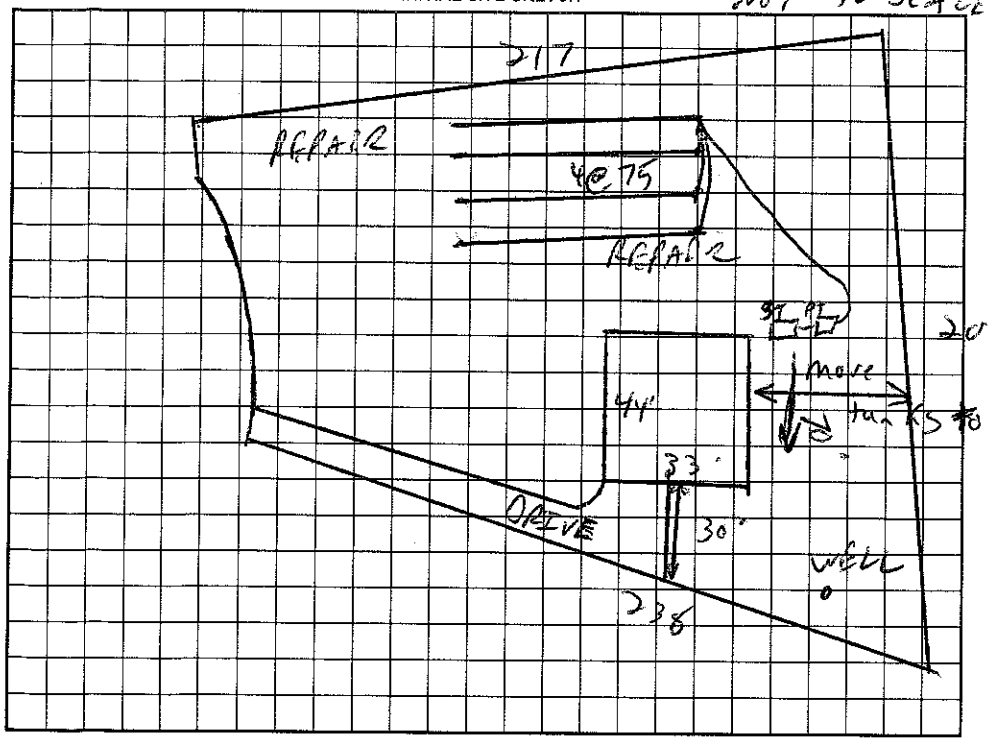

AS BUILT SKETCH

Permit can be suspended or revoked if any false information is supplied toward securing the permit/any unauthorized changes are made to the site/any unauthorized changes are made in the installation of the system. Improvement Permit with plat valid without expiration. Improvement Permit with site plan valid for sixty months. Authorization to Construct is valid for a period equal to that of Improvement Permit – not to exceed sixty months.

Signed: 4-19-99 date Installed by: STEVE JORDAN

Improvement Permit by: RS date 4/19/99 Operation Permit by: Wesley Sparks RS. date 11/29/99

Authorization to Construct by: RS date 4/19/99 Existing System Inspection by: date

HEALTH DEPT. COPY: WHITE OWNER COPY (FINAL): YELLOW OWNER COPY (INITIAL): PINK