IREDELL COUNTY HEALTH DEPARTMENT

STATESVILLE 704-878-5305 MOORESVILLE 704-664-5281

IMPROVEMENT PERMIT / AUTHORIZATION TO CONSTRUCT / OPERATION PERMIT / EXISTING SYSTEM INSPECTIO

PERMIT# 071789 PIN# 4658 37 9757 DATE 2/24/98

OWNER OR CONTRACTOR Louise Reading PHONE: Business _____ Home 660-3255

ADDRESS Po Box 93 Mooresville, NC 28115

LOCATION Bailey Rd. off 21 N TR Toucan Rd. on (L) at intersection of Gold Finch Lane

SUBDIVISION FARMDALE BLOCK / SECTION 2 LOT 18 LOT AREA .51AC SITE CLASS. P5 DESIGN FLOW 360 L.T.A.R. .3

Septic Tank: 1000 Gallons; STB 794 Date _____
Pump Tank: _____ Gallons; PT _____ Date _____
Pump Make: _____ Model _____ Serial No. _____
Nitrification Field: No Fields 1 Square Feet 900+ Linear Feet 300+
No Lines 3 Trench Width 36" Max Trench Bottom Depth 36" Gravel Depth SAND.

[X] New System ☐ Repair System Type: I, II, (III) IV, V, VI
System Description: GRAV - CIT PLASTIC
Repair System Description: SAME
Maintenance Agreement Required: ☐ Yes [X] No


[X] House/Mod. Home ☐ Mobile Home ☐ Business ☐ Other
No. Bedrooms 3 No. Bathrooms 2 No. Employees _____
☐ Slab [X] Crawl Space ☐ Basement w/plumbing ☐ Basement wo/plumbing

Water Supply: [X] Individual ☐ Public ☐ Community

Comments:/Conditions:

Comments:/Conditions:
16 shutell.d as drawn
4 to

INITIAL SITE SKETCH

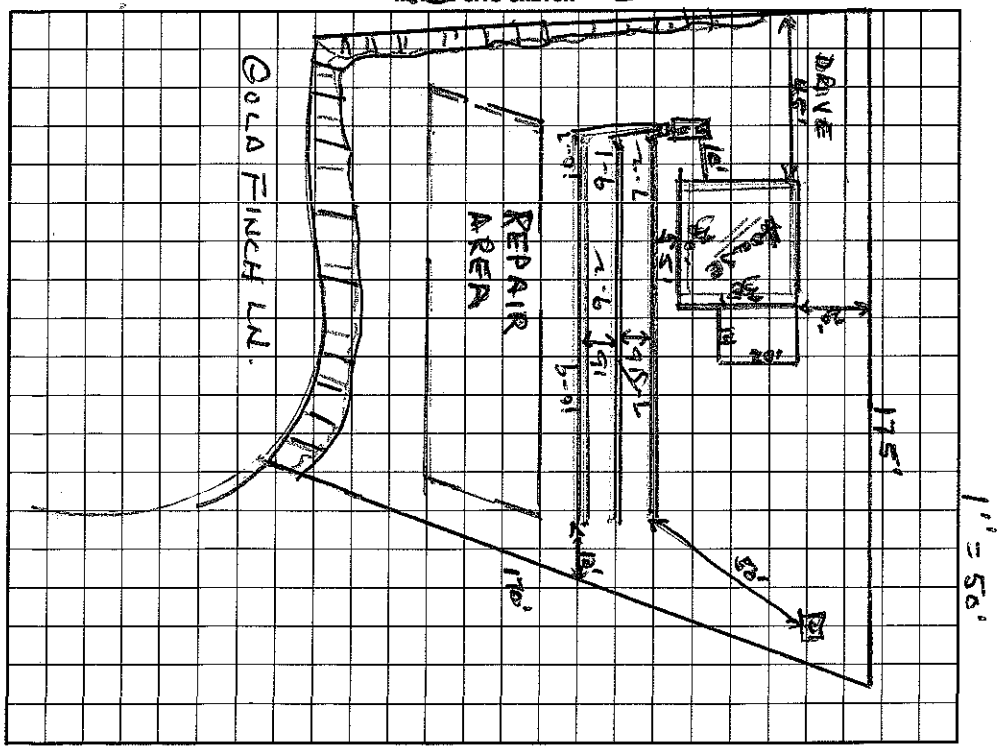

AS BUILT SKETCH

I understand that this permit can be suspended or revoked if any false information is supplied toward securing the permit/any unauthorized changes are made to the site/any unauthorized changes are made in the installation of the system. Improvement Permit with plat valid without expiration. Improvement Permit with site plan valid for sixty months. Authorization to Construct is valid for a period equal to that of Improvement Permit – not to exceed sixty months.

Signed: Louise Reading date 2-25-98
Improvement Permit by: Wesley Sparks RS. date 2/25/98
Authorization to Construct by: Wesley Sparks RS. date 2/25/98

Installed by: Chuck Grading
Operation Permit by: Wesley Sparks RS date 6/9/98
Existing System Inspection by: Wesley Sparks RS date 6/9/98

HEALTH DEPT. COPY: WHITE INSPECTION COPY (FINAL): GREEN OWNER COPY (FINAL): YELLOW INSPECTION COPY (INITIAL): PINK OWNER COPY (INITIAL): GOLD