IREDELL COUNTY HEALTH DEPARTMENT

S[illegible]VILLE 704-878-5305 50.00 Paid MOORESVILLE 704-664-5281

IMPROVEMENT PERMIT / AUTHORIZATION TO CONSTRUCT / OPERATION PERMIT / EXISTING SYSTEM INSPECTION

PERMIT# 104960 PIN# 4658 46 2131 DATE 6/10/02

OWNER OR CONTRACTOR James Brotherton PHONE: Business _____ Home 704-663-5691

ADDRESS 217 Bailey Rd. Mooresville, NC. 28117

LOCATION 21N TL Bailey Rd. ~.5 mile on (L) just past #217 driveway

SUBDIVISION Green Meadows BLOCK / SECTION _____ LOT 10 LOT AREA ~2.7AC SITE CLASS PS DESIGN FLOW 360 L.T.A.R. .25

Septic Tank: 1000 Gallons; STB _____ Date _____

Pump Tank: _____ Gallons; PT _____ Date _____

Pump Make: _____ Model _____ Serial No. _____

Nitrification Field: No Fields 1 Square Feet 1440 Linear Feet 480

No Lines 6 @ 80' Trench Width 3' Max Trench Bottom Depth 3' Gravel Depth 12"

☑ New System ☐ Repair System Type: I (II) III, IV, V, VI

System Description: Drop Box - Conventional

Repair System Description: Same

Maintenance Agreement Required: ☐ Yes ☒ No

☒ House/Mod. Home No. Bedrooms 3

☐ Mobile Home No. Bathrooms 3

☐ Business No. Employees _____

☐ Other _____


☐ Slab ☒ Crawl Space ☐ Basement w/plumbing ☐ Basement wo/plumbing

Water Supply: ☒ Individual ☐ Public ☐ Community BROTHERTON


Comments:/Conditions: Lines on contour - Final grade must be sloped to drain adequately.

Comments:/Conditions:

INITIAL SITE SKETCH

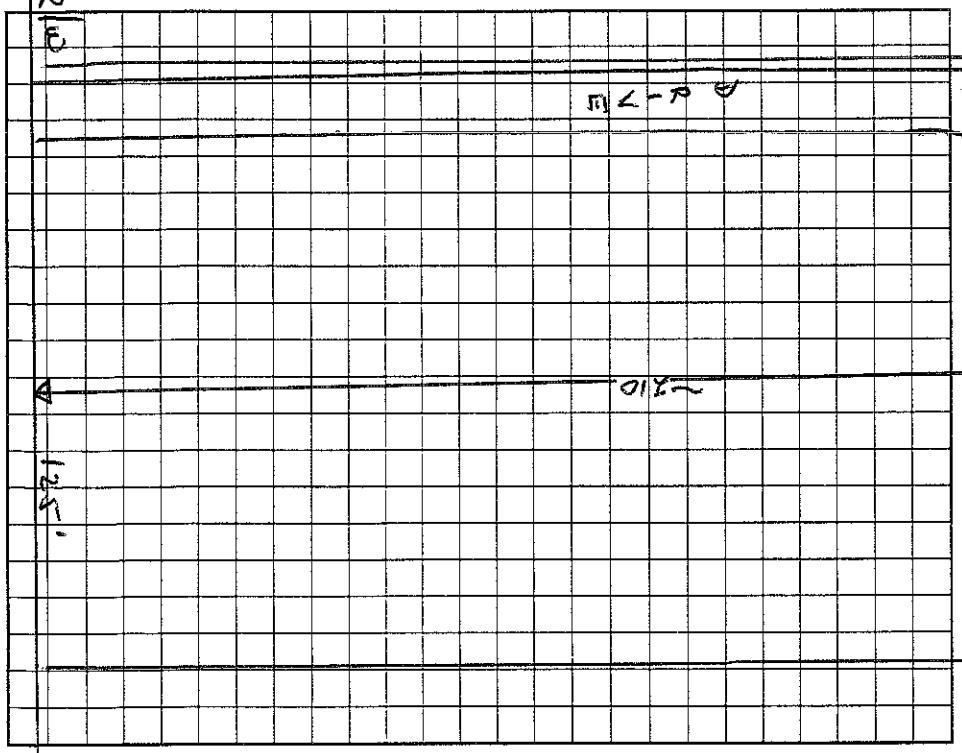

AS BUILT SKETCH

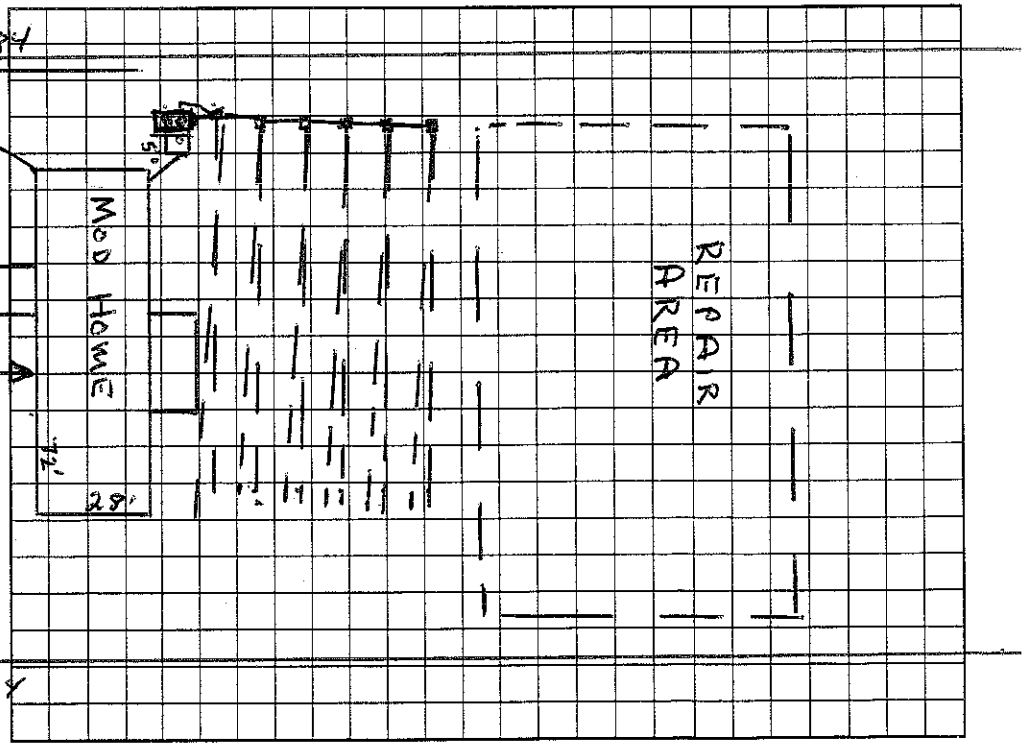

Permit can be suspended or revoked if any false information is supplied toward securing the permit/any unauthorized changes are made to the site/any unauthorized changes are made in the installation of the system. Improvement Permit with plat valid without expiration. Improvement Permit with site plan valid for sixty months. Authorization to Construct is valid for a period equal to that of Improvement Permit – not to exceed sixty months.

Signed: * Jim Brotherton date 6-17-02 Installed by: Wayne County

Improvement Permit by: Wesley Sparks R.S. date 6/10/02 Operation Permit by: Wesley Sparks R.S. date 7/10/02

Authorization to Construct by: Wesley Sparks RS date 6/10/02 Existing System Inspection by: _____ date _____

HEALTH DEPT. COPY: WHITE OWNER COPY (FINAL): YELLOW OWNER COPY (INITIAL): PINK