PIN# 4658-46-2675

IREDELL COUNTY HEALTH DEPARTMENT

STATESVILLE 704-878-5305 MOORESVILLE 704-664-5281

IMPROVEMENT PERMIT / CERTIFICATE OF COMPLETION / OPERATION PERMIT / EXISTING SYSTEM INSPECTION

PROPERTY DESCRIPTION NO. 21257 DATE July 2, '95 TAX MAP NO. part of 1 RA10 Watershed: ☑ Yes ☐ No

OWNER OR CONTRACTOR Bill Ball PHONE: Business _____ Home _____

ADDRESS Rt 2 Box 303A Hiddenite NC 28636

LOCATION 21 N to TR Bailey Road approx ½ mile on Right

SUBDIVISION Farmdale BLOCK / SECTION 1 LOT 4 LOT AREA .56 Ac SITE CLASS. PS DESIGN FLOW 360 gpd L.T.A.R. .3

Septic Tank: 1000 Gallons; STB 825 Date 10-7-96

Pump Tank: _____ Gallons; PT _____ Date _____

Pump Make: _____ Model _____ Serial No. _____

Nitrification Field: No Fields 1 Square Feet 1202 Linear Feet 400

No Lines 5@80' Trench Width 36" Max Trench Bottom Depth 36" Gravel Depth 12"

☑ New System ☐ Repair System Type: I, II, III, IV, V, VI

System Description: gravity conventional

Repair System Description: same

Maintenance Agreement Required: ☐ Yes ☑ No

☑ House/Mod. Home No. Bedrooms 3

☐ Mobile Home No. Bathrooms 2

☐ Business No. Employees _____

☐ Other _____

☐ Slab ☑ Crawl Space ☐ Basement w/plumbing ☐ Basement wo/plumbing

Water Supply: ☑ Individual ☐ Community ☐ Public


Comments:

12-2-96 OK to use Drop Boxes if denied.

Comments:

1" = 50'

INITIAL SITE SKETCH

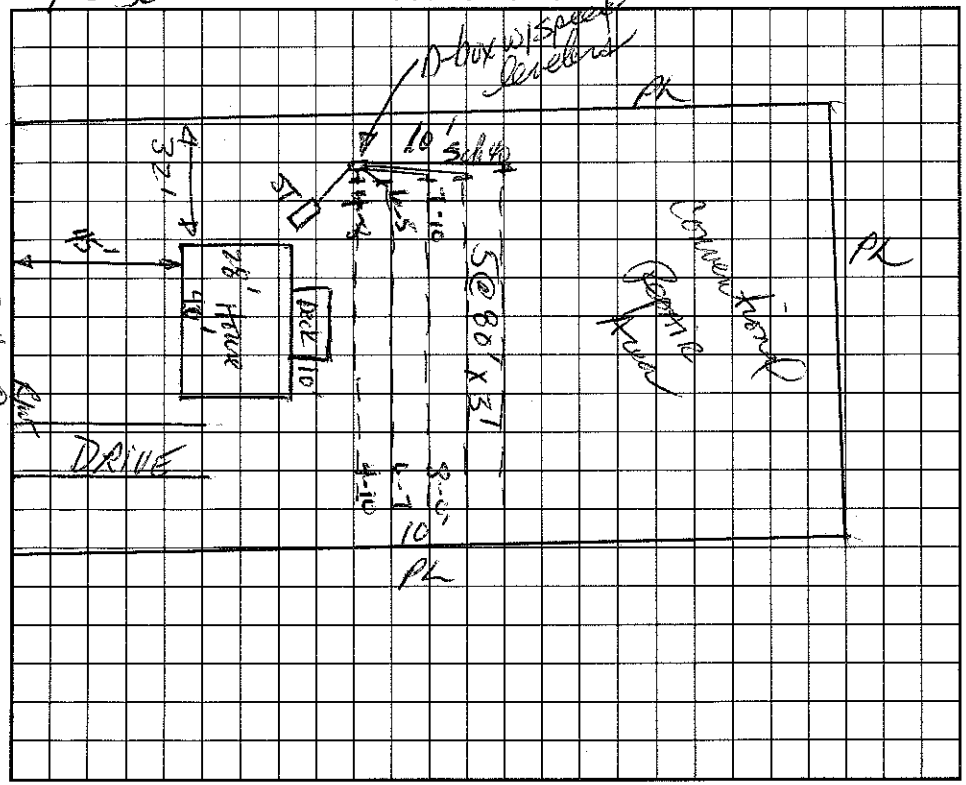

AS BUILT SKETCH

I understand that this permit can be suspended or revoked if any false information is supplied toward securing the permit/any unauthorized changes are made to the site/any unauthorized changes are made in the installation of the system. Improvement Permit is valid for 60 months from date of issuance.

Signed: Bill Ball

Improvement Permit by: _____, RS date 7/2/95

Existing System Inspection by: _____ date _____

Installed by: Wayne County

Certificate of Completion by: _____ date _____

Operation Permit by: Wesley Sparks RS date 12/5/96

HEALTH DEPT. COPY: WHITE INSPECTION COPY (FINAL): GREEN OWNER COPY (FINAL): YELLOW INSPECTION COPY (INITIAL): PINK OWNER COPY (INITIAL): GOLD