PIN# 4658-46-5659

IREDELL COUNTY HEALTH DEPARTMENT

STATESVILLE 704-878-5305 MOORESVILLE 704-664-5281

IMPROVEMENT PERMIT / CERTIFICATE OF COMPLETION / OPERATION PERMIT / EXISTING SYSTEM INSPECTION

PROPERTY DESCRIPTION NO. 21261 DATE May 3 '96 TAX MAP NO. part of 1RA10 Watershed: ☑ Yes ☐ No

OWNER OR CONTRACTOR Bill Ball PHONE: Business _____ Home _____

ADDRESS Rt 2 Box 303A Hiddenite NC 28636

LOCATION 21N TL Bailey Rd ~¼-½ mile on Right

SUBDIVISION Avondale BLOCK / SECTION 1 LOT 2 LOT AREA 1.82Ac SITE CLASS. B DESIGN FLOW 360 gpd L.T.A.R. 2.3

Septic Tank: 1000 Gallons; STB 625 Date 1/6/97

Pump Tank: _____ Gallons; PT _____ Date _____

Pump Make: _____ Model _____ Serial No. _____

Nitrification Field: No Fields 1 Square Feet 1200 Linear Feet 400

No Lines See 1 Trench Width 36" Max Trench Bottom Depth 36" Gravel Depth 12"

☑ New System ☐ Repair System Type: I II III IV V VI

System Description: gravity conventional

Repair System Description: gravity conventional

Maintenance Agreement Required: ☐ Yes ☑ No

☑ House/Mod. Home No. Bedrooms 3

☐ Mobile Home No. Bathrooms 2

☐ Business No. Employees _____

☐ Other _____

☐ Slab ☑ Crawl Space ☐ Basement w/plumbing ☐ Basement wo/plumbing


Water Supply: ☑ Individual ☐ Community ☐ Public

Comments: All parts of old septic system are encountered "dig out" 6' minimum from new lines & pack w/ "clean" dirt.


Comments: Recommend existing power pole be moved.

Charged to 60 @ 67'x3 - 4/10/97 AWS

INITIAL SITE SKETCH

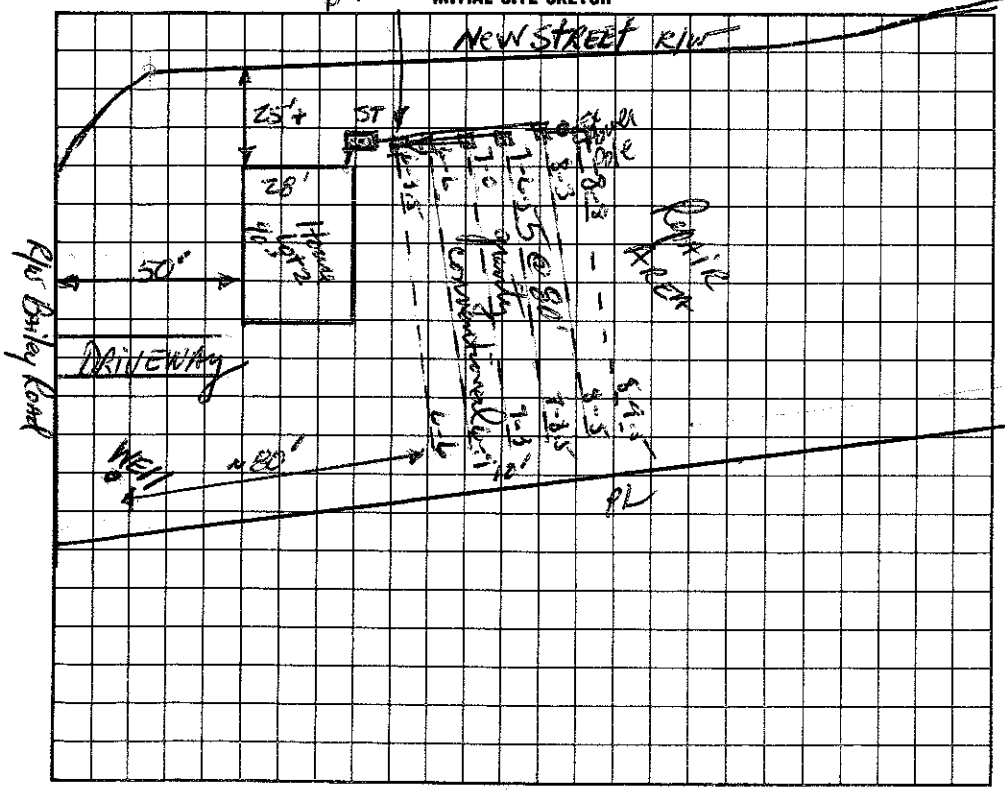

AS BUILT SKETCH

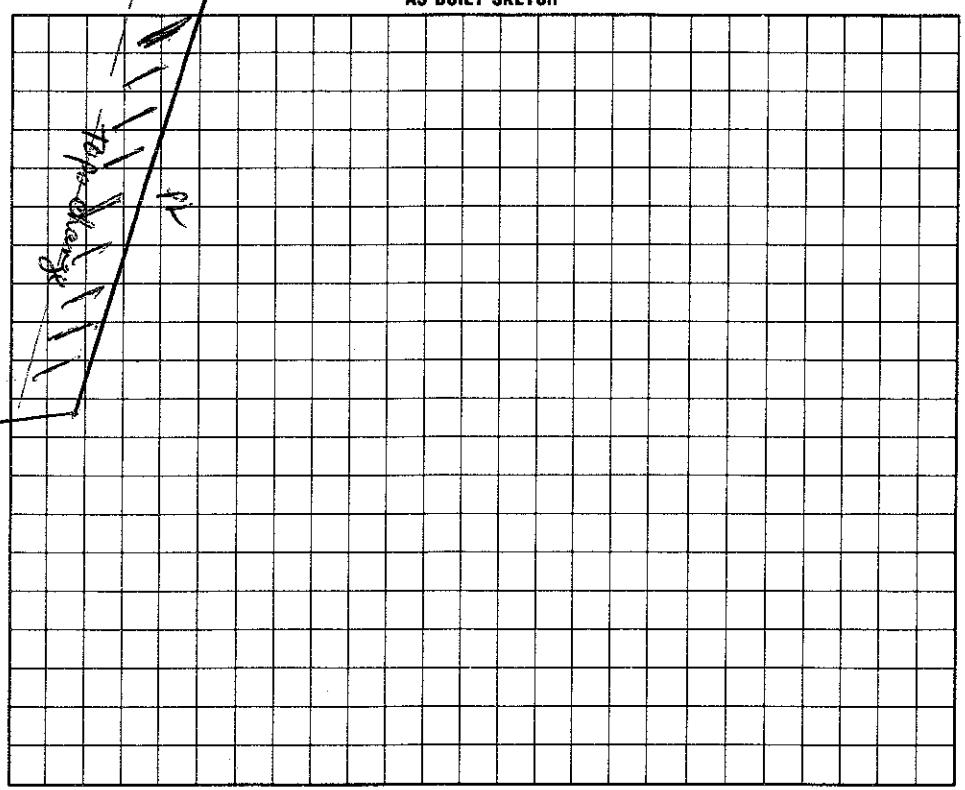

I understand that this permit can be suspended or revoked if any false information is supplied toward securing the permit/any unauthorized changes are made to the site/any unauthorized changes are made in the installation of the system.

Signed: Bill Ball

Improvement Permit by: Jerry Henson IRS date 5-3-96

~~Existing System Inspection by:~~ Construction Authorization by: Jerry Henson IRS date 5-3-96

Installed by: Wayne Clontz

Certificate of Completion by: Wesley Speaks R.S. date 4/11/97

Operation Permit by: Wesley Speaks R.S. date 4/11/97

HEALTH DEPT. COPY: WHITE INSPECTION COPY (FINAL): GREEN OWNER COPY (FINAL): YELLOW INSPECTION COPY (INITIAL): PINK OWNER COPY (INITIAL): GOLD