IREDELL COUNTY HEALTH DEPARTMENT

STATESVILLE 704-878-5305 MOORESVILLE 704-664-5281

IMPROVEMENT PERMIT / CERTIFICATE OF COMPLETION / OPERATION PERMIT / EXISTING SYSTEM INSPECTION

PROPERTY DESCRIPTION NO. 069099 DATE 9/12/97 TAX MAP NO. 4658466103 Watershed: ☑ ~~YES~~ ☐ No

OWNER OR CONTRACTOR GARY & ROSE BOLICK PHONE: Business _____ Home 663-6981

ADDRESS 207 BAILEY RD - MOORESVILLE NC 28115

LOCATION 215 - TR BAILEY RD - ACROSS FROM TOUCAN ON LEFT

SUBDIVISION GREENMEADOWS BLOCK / SECTION _____ LOT 7 LOT AREA 2.27 SITE CLASS. PS DESIGN FLOW 240 L.T.A.R. ~~—~~

Septic Tank: _____ Gallons; STB _____ Date _____

Pump Tank: _____ Gallons; PT EXISTING Date _____

Pump Make: _____ Model _____ Serial No. _____

Nitrification Field: No Fields ____ Square Feet _____ Linear Feet _____

No Lines _____ Trench Width _____ Max Trench Bottom Depth _____ Gravel Depth _____

☑ New System ☐ Repair System Type: I, II, III, IV, V, VI

System Description: GRAVITY CONVENTIONAL

Repair System Description: SAME

Maintenance Agreement Required: ☐ Yes ☑ No

☑ House/Mod. Home No. Bedrooms 3

☐ Mobile Home No. Bathrooms 2

☐ Business No. Employees ____

☐ Other _____

☐ Slab ☑ Crawl Space ☐ Basement w/plumbing ☐ Basement wo/plumbing


Water Supply: ☑ Individual ☐ Community ☐ Public

Comments:

Comments: SYSTEM APPROVED FOR 3BR - BUT 2BR WILL BE HOOKED UP.

INITIAL SITE SKETCH

AS BUILT SKETCH

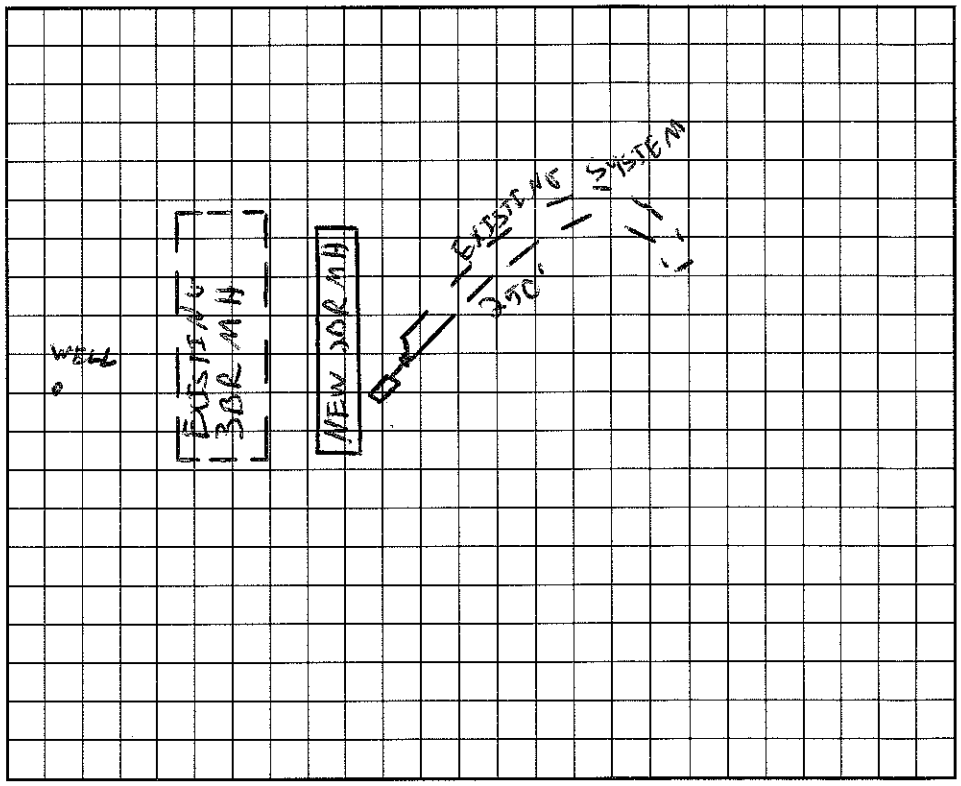

I understand that this permit can be suspended or revoked if any false information is supplied toward securing the permit/any unauthorized changes are made to the site/any unauthorized changes are made in the installation of the system. Improvement Permit is valid for 60 months from date of issuance.

Signed: Gary Bolick

Improvement Permit by: _____ date _____

Existing System Inspection by: C. Ray Tew date 9/12/97

Installed by: _____

Certificate of Completion by: _____ date _____

Operation Permit by: C. Ray Tew date 9/12/97

HEALTH DEPT. COPY: WHITE INSPECTION COPY (FINAL): GREEN OWNER COPY (FINAL): YELLOW INSPECTION COPY (INITIAL): PINK OWNER COPY (INITIAL): GOLD