IREDELL COUNTY HEALTH DEPARTMENT

Statesville Office (704) 878-5305 Mooresville Office (704) 660-3625 PERMIT # 2096445

IMPROVEMENT PERMIT / AUTHORIZATION TO CONSTRUCT / OPERATION PERMIT / EXISTING SYSTEM

PIN # 4658-46-7132 218539

APPLICANT: DAWN VASEY APPLICANT ADDRESS: 199 BAILEY RD.

SITE ADDRESS: 199 BAILEY RD. - Mooresville PHONE: 704-578-4951 ALT. PHONE:

SITE DIRECTIONS: HWY 21 TO BAILEY RD. LOT ON L

SUBDIVISION: GREEN MEADOWS SECTION: - LOT # 6 LOT AREA: 2.28 AC DESIGN FLOW: 360 L.T.A.R.: .3

Septic Tank 1000 (gal) STB 760 Date 4-20

Pump Tank (gal) PT Date

Pump Make Model Serial #

Nitrification Fields 1 # Lines 2@33' Linear Ft: 66'

Trench Width 24" Max. Trench Bottom Depth *58"* Gravel Depth —

☐ New System ☐ Repair ☒ Expansion System Type: I II III IV V VI

System Description: EXISTING BED + PANEL BLOCK

Repair System Description: PANEL BLOCK

Maintenance Agreement Required: ☐ YES ☒ NO

☒ GRAVITY ☐ PRESSURE

☒ Residence ☐ Business ☐ Other ☐ Slab ☒ Crawl Space ☐ Basement w/plumbing ☐ Basement w/o plumbing

No. Bedrooms 3 No. Persons No. Employees

Water Supply: ☒ Private ☐ Public ☐ Community

Comments / Conditions: TRENCH BOTTOM = 58"*
NEED WELL ABANDOND BEFORE AC
NEED LETTER FROM TEJ PANEL FOR 58" TB BEFORE AC

*-4-15-16 See attached email from Brad Johnson (manufacturer) regarding deep trench installation of Panel-Block systems. Recommend pumping septic tank every 3-5 years. Trailer appears to be ~64'x30' and is 11' more wide than was

INITIAL SITE SKETCH

REPLACE CRUSHED TANK

SEE PLAN FROM

KATHLEEN SAUNDERS

Well Abandoned 3-3-2016
GW-30 Received 3-7-2016

AS BUILT SKETCH

approved in the IP however doesn't appear to impact the septic system. -SA

INSTALLED AS SHOWN SA

Permit can be suspended or revoked if any false information is supplied toward securing the permit / any unauthorized changes are made to the site / any unauthorized changes are made in the installation of the system. **CONTACT A LOCATOR SERVICE PRIOR TO ANY EXCAVATION**

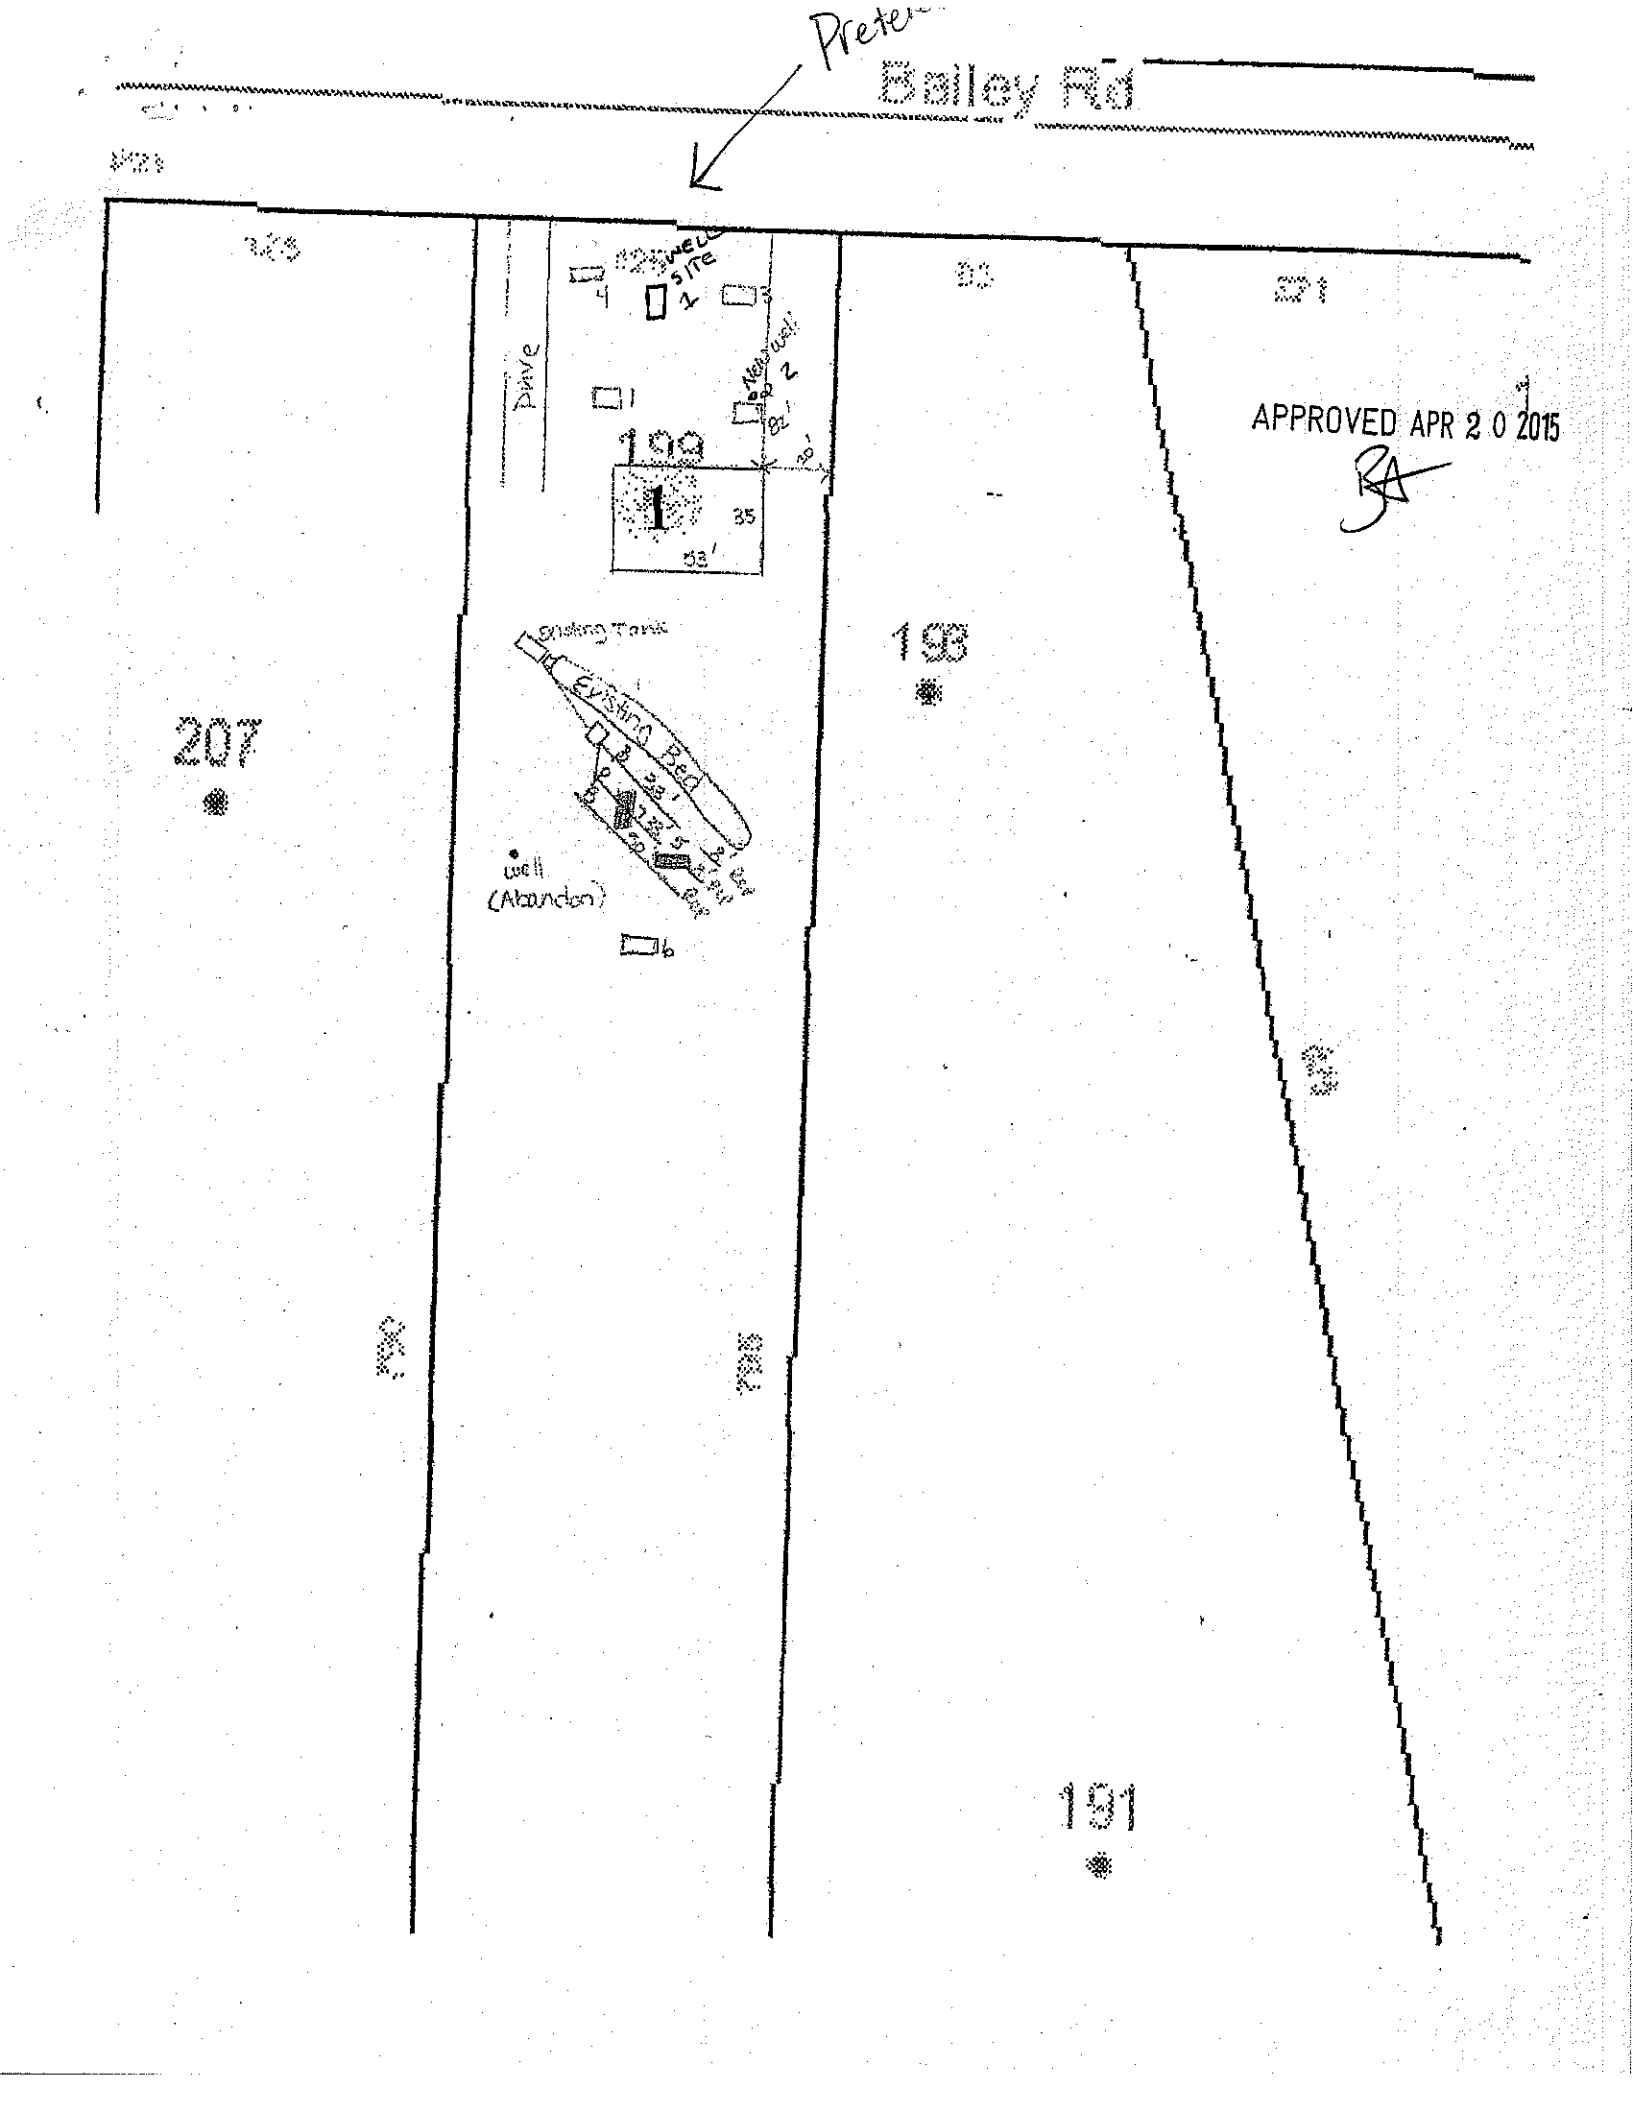
☐ **IMPROVEMENT PERMIT** *with plat valid without expiration* ☒ **IMPROVEMENT PERMIT** *with site plan valid for 60 mos.* ☒ **AUTHORIZATION TO CONSTRUCT** *valid for period equal to IMPROVEMENT PERMIT--not to exceed 60 mo.*

Owner / Applicant Signature: Kathleen Saunders Date: 4-23-15 Installed by: Tim Abee

IMPROVEMENT PERMIT by: RA Ellis APPROVED Date: APR 20 2015 OPERATION PERMIT by: RA Ellis APPROVED JUN 21 2016

AUTHORIZATION TO CONSTRUCT by: Tom Rhuck Date: 4-15-2016 Existing System Inspected by: Date:

Health Dept. Copy - WHITE Applicant (Final Approval) - YELLOW Applicant (Conditional Approval) - PINK


Bailey Rd
Drive
Well site
New well
199
1
35
53'
Existing Tank
Existing Bed
well
(Abandon)
198
207
191
APPROVED APR 2 0 2015