IREDELL COUNTY HEALTH DEPARTMENT

STATESVILLE 704-878-5305 MOORESVILLE 704-664-5281

IMPROVEMENT PERMIT / AUTHORIZATION TO CONSTRUCT / OPERATION PERMIT / EXISTING SYSTEM INSPECTION

PERMIT# 23415 PIN# ~~TM-13 A 5~~ 4658-46-8082 DATE 4/17/98

OWNER OR CONTRACTOR Ronald Mills PHONE: Business 664-4496 Home 664-5199

ADDRESS 191 Bailey Rd Mooresville, NC 28115

LOCATION Hwy 21 N TL Bailey Rd approx 1/4 mile (7th Drive on left)

SUBDIVISION Green Meadows BLOCK / SECTION ____ LOT 5 LOT AREA of 3.39 Acre SITE CLASS. PS DESIGN FLOW 360gpd L.T.A.R. .3

Septic Tank: 1000 Gallons; STB 826 Date 3/2/98

Pump Tank: ____ Gallons; PT ____ Date ____

Pump Make: ____ Model ____ Serial No. ____

Nitrification Field: No Fields 1 Square Feet 1200' Linear Feet 400'

No Lines 5 at 80' Trench Width 36" Max Trench Bottom Depth 24" Gravel Depth 12"

☒ New System ☐ Repair System Type: I, (II), III, IV, V, VI

System Description: Grav. - Conventional

Repair System Description: Pump - Modified

Maintenance Agreement Required: ☐ Yes ☒ No

☐ House/Mod. Home ☒ Mobile Home ☐ Business ☐ Other ____

No. Bedrooms 3 No. Bathrooms 2 No. Employees ____


☐ Slab ☒ Crawl Space ☐ Basement w/plumbing ☐ Basement wo/plumbing

Water Supply: ☒ Individual ☐ Public ☐ Community Shared well

Comments:/Conditions: Keep Septic System 100' from well at least 5' from house & 10' from PL

Comments:/Conditions: Installed as drawn.

INITIAL SITE SKETCH Scale 1:50

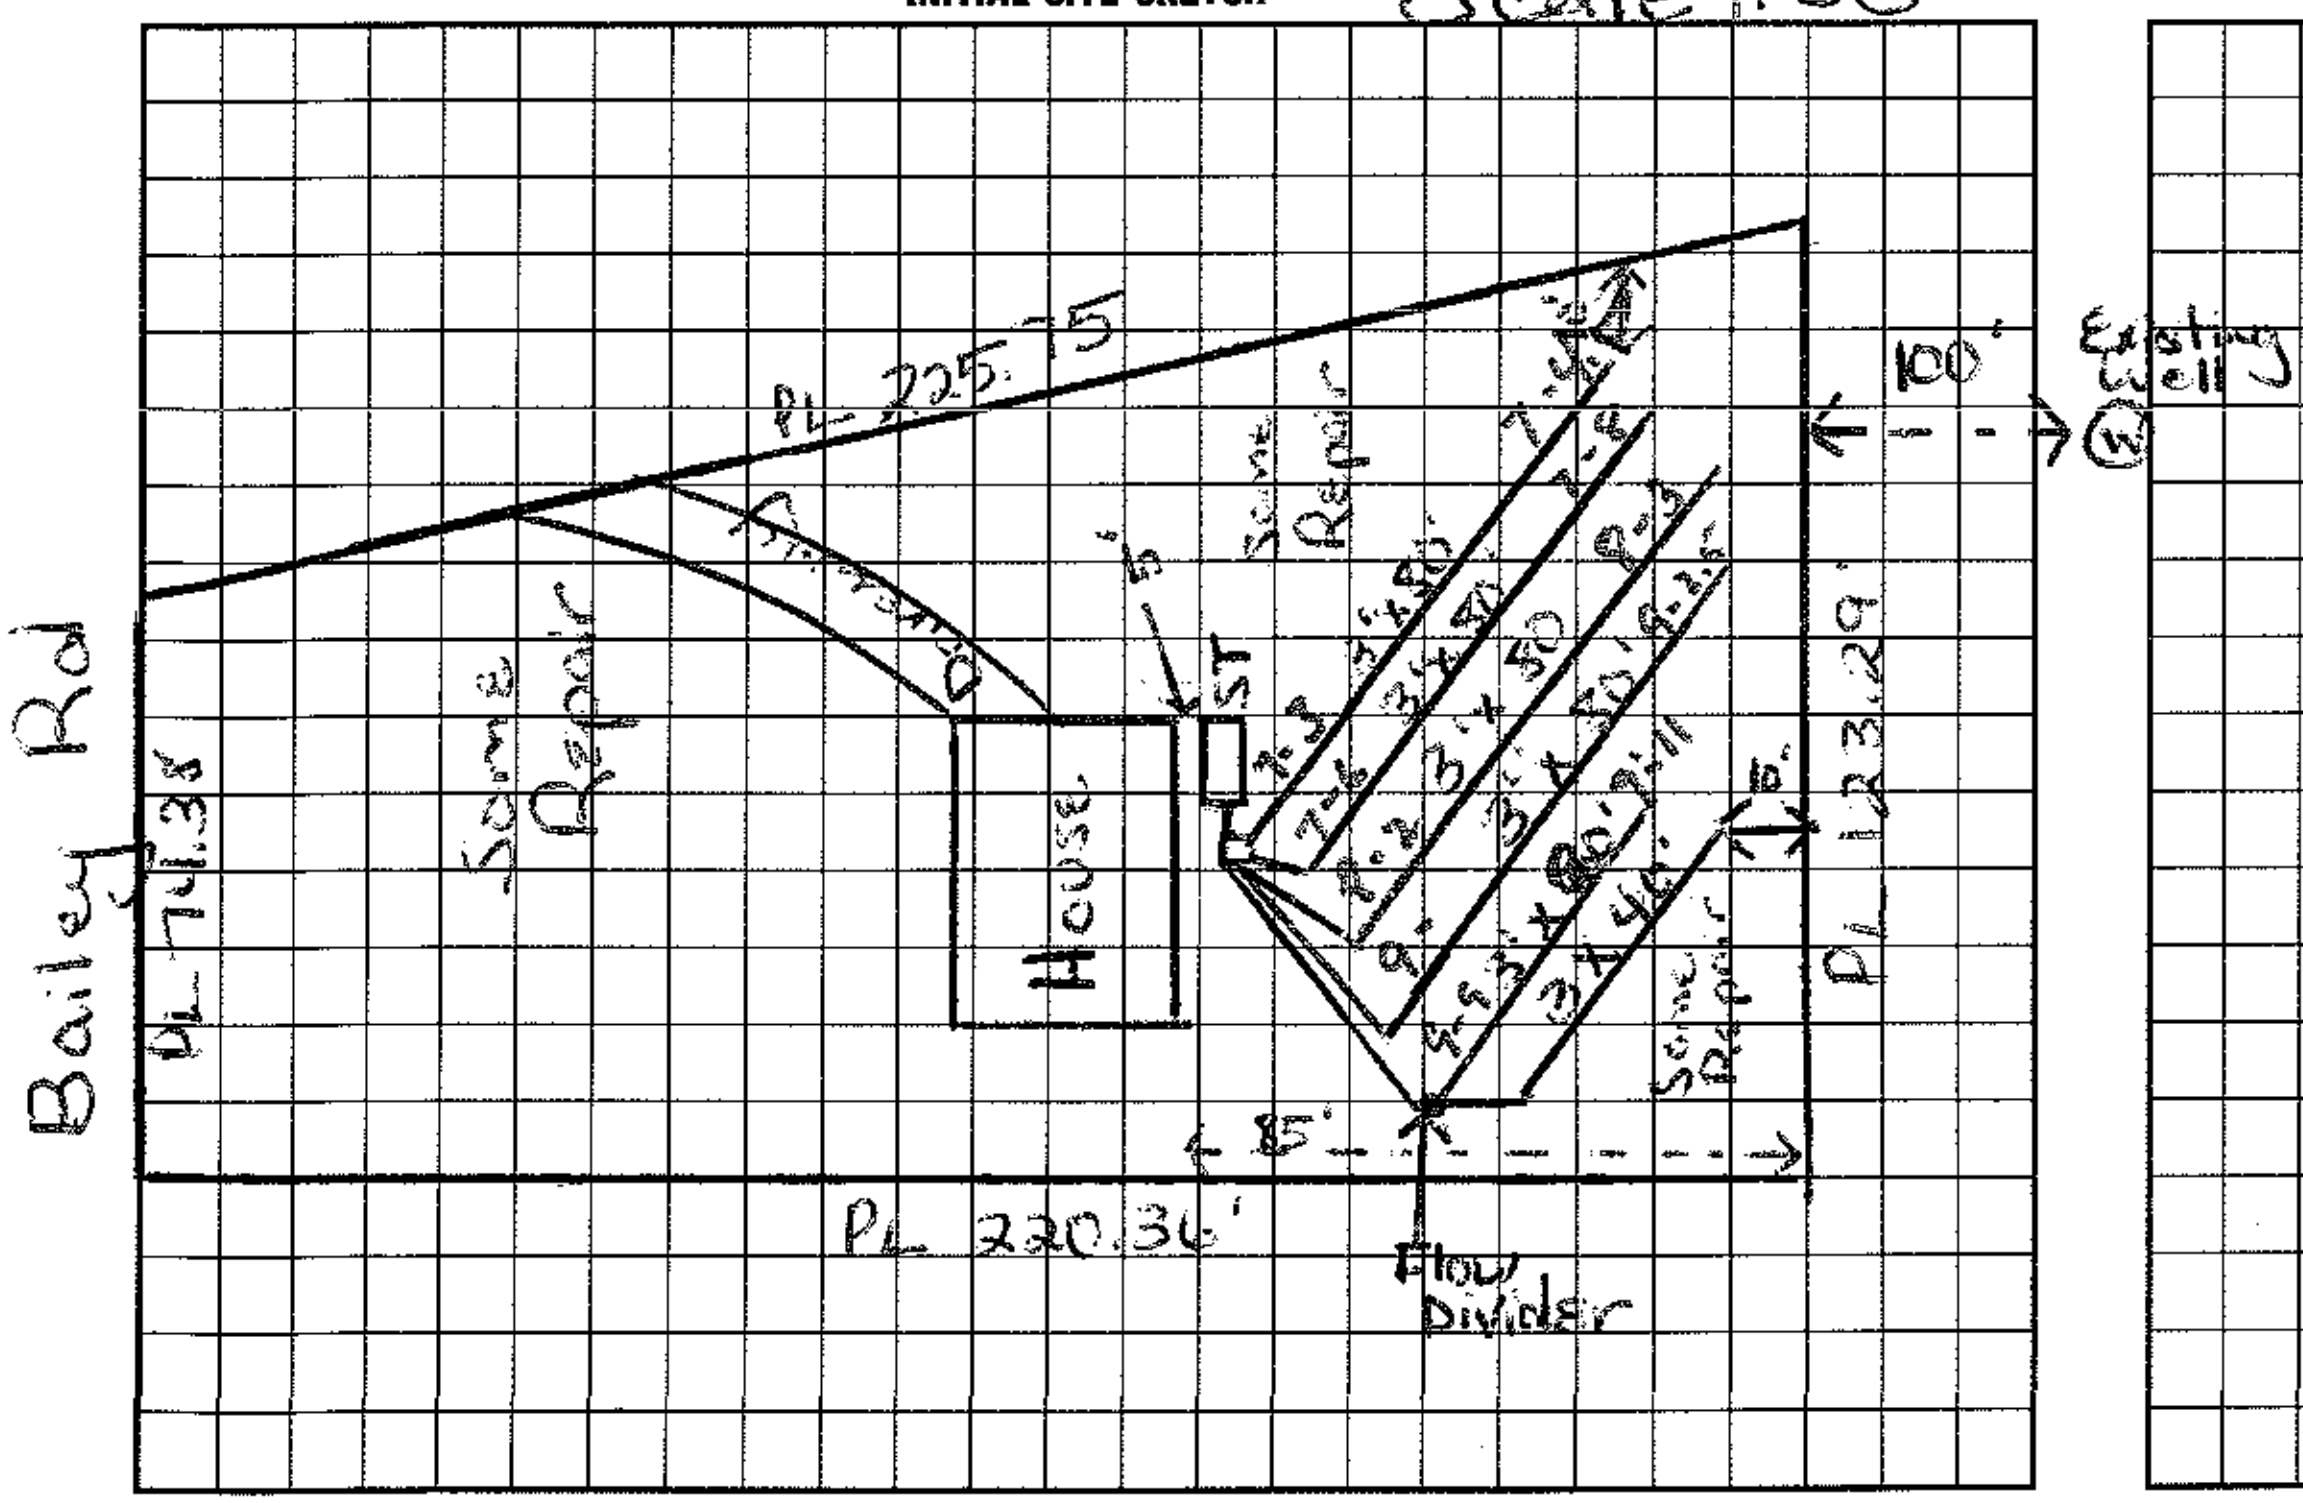

AS BUILT SKETCH

I understand that this permit can be suspended or revoked if any false information is supplied toward securing the permit/any unauthorized changes are made to the site/any unauthorized changes are made in the installation of the system. Improvement Permit with plat valid without expiration. Improvement Permit with site plan valid for sixty months. Authorization to Construct is valid for a period equal to that of Improvement Permit – not to exceed sixty months.

Signed: Ray Mills date 4-20-98

Improvement Permit by: Maria H. Dotson date 4/20/98

Authorization to Construct by: Maria H. Dotson date 4/20/98

Installed by: Wayne Clontz

Operation Permit by: Wesley Sparks R.S. date 5/18/98

Existing System Inspection by: Wesley Sparks R.S. date 5/18/98

HEALTH DEPT. COPY: WHITE INSPECTION COPY (FINAL): GREEN OWNER COPY (FINAL): YELLOW INSPECTION COPY (INITIAL): PINK OWNER COPY (INITIAL): GOLD