# IREDELL COUNTY HEALTH DEPARTMENT

Authorization to Construct — 2,00

STATESVILLE 704-878-5305 — MOORESVILLE 704-664-5281

## IMPROVEMENT PERMIT / ~~CERTIFICATE OF COMPLETION~~ / OPERATION PERMIT / EXISTING SYSTEM INSPECTION

PROPERTY DESCRIPTION NO. 066804 DATE 5/6/97 TAX MAP NO. 4658 47 ~~49 44~~ 0529 Watershed: ☐ Yes ☒ No

OWNER OR CONTRACTOR E. Lowyn Tatum PHONE: Business Home 664-7392

ADDRESS 382 Templeton Rd. Mooresville, NC. 28115

LOCATION 2 IN TL Bailey Rd TR Toucan Rd. on (R) past Wren Lane

SUBDIVISION Founders BLOCK / SECTION II LOT 19 LOT AREA .55 Ac SITE CLASS. PS DESIGN FLOW 360 L.T.A.R. .3

Septic Tank: 1000 Gallons; STB 825 Date 10/11/98
Pump Tank: ____ Gallons; PT ____ Date ____
Pump Make: ____ Model ____ Serial No. ____
Nitrification Field: No Fields 1 Square Feet 1200 Linear Feet 400
No Lines 5 Trench Width 36" Max Trench Bottom Depth 30" Gravel Depth ~~12~~ 11"

☒ New System ☐ Repair System Type: I (II) III, IV, V, VI
System Description: GRAV CONVENTIONAL
Repair System Description: C/H. PLASTIC
Maintenance Agreement Required: ☐ Yes ☒ No


☒ House/Mod. Home No. Bedrooms 3
☐ Mobile Home No. Bathrooms 2
☐ Business No. Employees ____
☐ Other ____
☐ Slab ☒ Crawl Space ☐ Basement w/plumbing ☐ Basement wo/plumbing

Water Supply:
☒ Individual
☐ Community
☐ Public


Comments:

Comments:

**INITIAL SITE SKETCH**

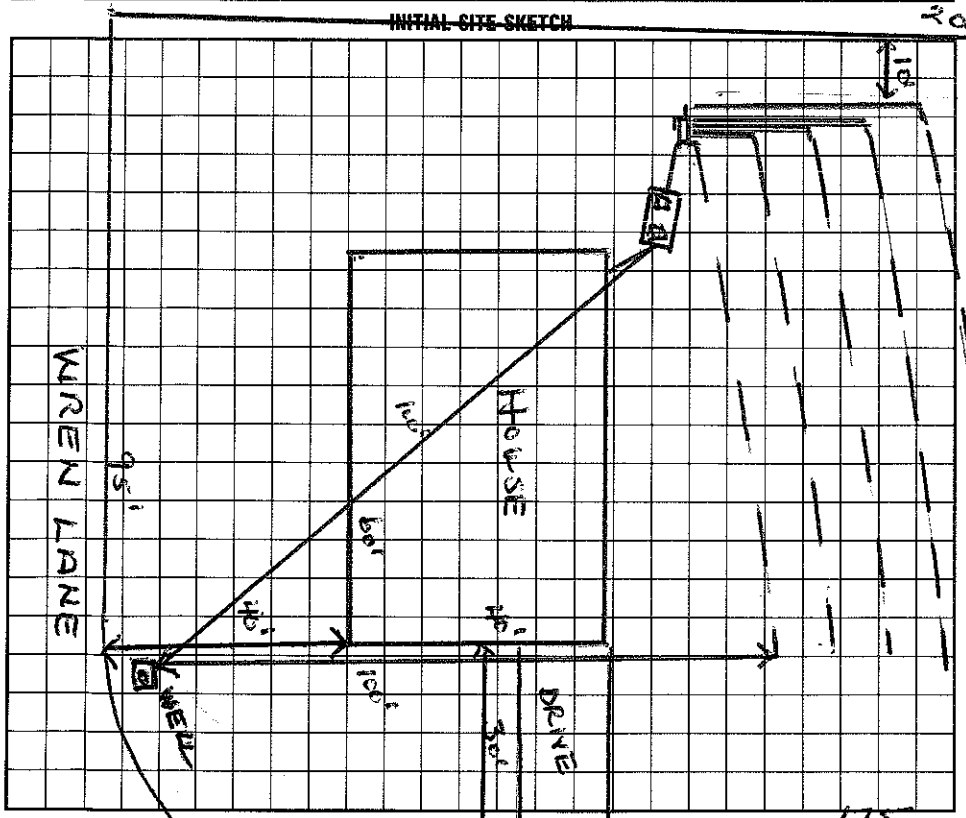


**AS BUILT SKETCH**

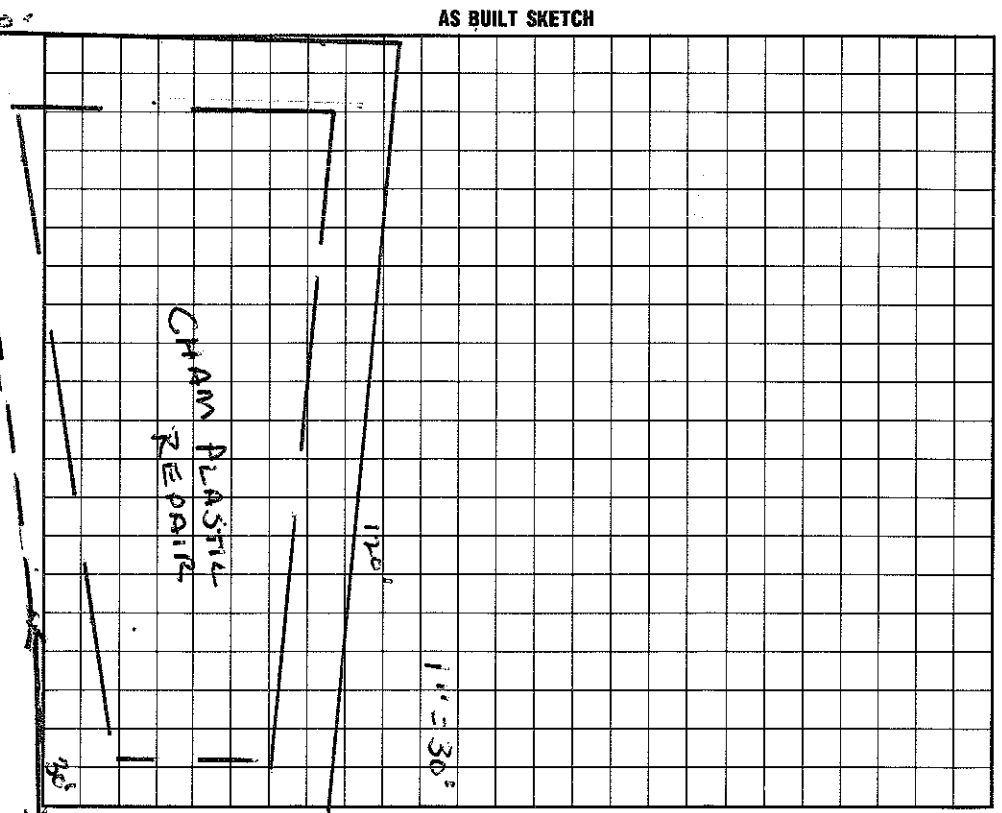


I understand that this permit can be suspended or revoked if any false information is supplied toward securing the permit/any unauthorized changes are made to the site/any unauthorized changes are made in the installation of the system. Improvement Permit is valid for 60 months from date of issuance.

Signed: ~~*~~ E. Tatum

Improvement Permit by: Wesley Sparks R.S. date 5/6/97

Existing System Inspection by: Wesley Sparks R.S. date 5/6/97

Installed by: D. Bostian

Certificate of Completion by: ____ date ____

Operation Permit by: [signature] R.S. date 11/13/98

HEALTH DEPT. COPY: WHITE — INSPECTION COPY (FINAL): GREEN — OWNER COPY (FINAL): YELLOW — INSPECTION COPY (INITIAL): PINK — OWNER COPY (INITIAL): GOLD