IREDELL COUNTY HEALTH DEPARTMENT

AUTHORIZATION PIN# 4658-47-1200 2nd

STATESVILLE 704-878-5305 MOORESVILLE 704-664-5281

IMPROVEMENT PERMIT / ~~CERTIFICATE OF COMPLETION~~ / OPERATION PERMIT / EXISTING SYSTEM INSPECTION

PROPERTY DESCRIPTION NO. 25705 DATE 12/11/96 TAX MAP NO. 1R-A-(9 & 10 pt) Watershed: ☑ Yes ☐ No

OWNER OR CONTRACTOR BILL BALL PHONE: Business 244-0264 Home

ADDRESS RT #2 BOX 303 A HIDDENITE NC

LOCATION ~~2445 BOX 303~~ 21 N - TL BAILEY RD - TR TOUCAN RD - ON L-Lt.

SUBDIVISION CARMDALE BLOCK / SECTION II LOT 25 LOT AREA 1.62 AC SITE CLASS. A5 DESIGN FLOW 360 GPD L.T.A.R. .30 GPD/FT²

Septic Tank: 1000 Gallons; STB 794 Date 6/3/97

Pump Tank: ____ Gallons; PT ____ Date ____

Pump Make: ____ Model ____ Serial No. ____

Nitrification Field: No Fields 1 Square Feet 1200 Linear Feet 400

No Lines 5 Trench Width 36" Max Trench Bottom Depth 24" Gravel Depth 12"

☑ New System ☐ Repair System Type: I, II, III, IV, V, VI

System Description: GRAVITY CONVENTIONAL

Repair System Description: DANEL

Maintenance Agreement Required: ☐ Yes ☑ No

☑ House/Mod. Home No. Bedrooms 3

☐ Mobile Home No. Bathrooms 2

☐ Business No. Employees ____

☐ Other ____


☐ Slab ☑ Crawl Space ☐ Basement w/plumbing ☐ Basement wo/plumbing

Water Supply: ☑ Individual ☐ Community ☐ Public


Comments: TERRACES ARE TO BE REMOVED AND SMOOTHED FOR GENTLE SLOPE.

Comments:

INITIAL SITE SKETCH

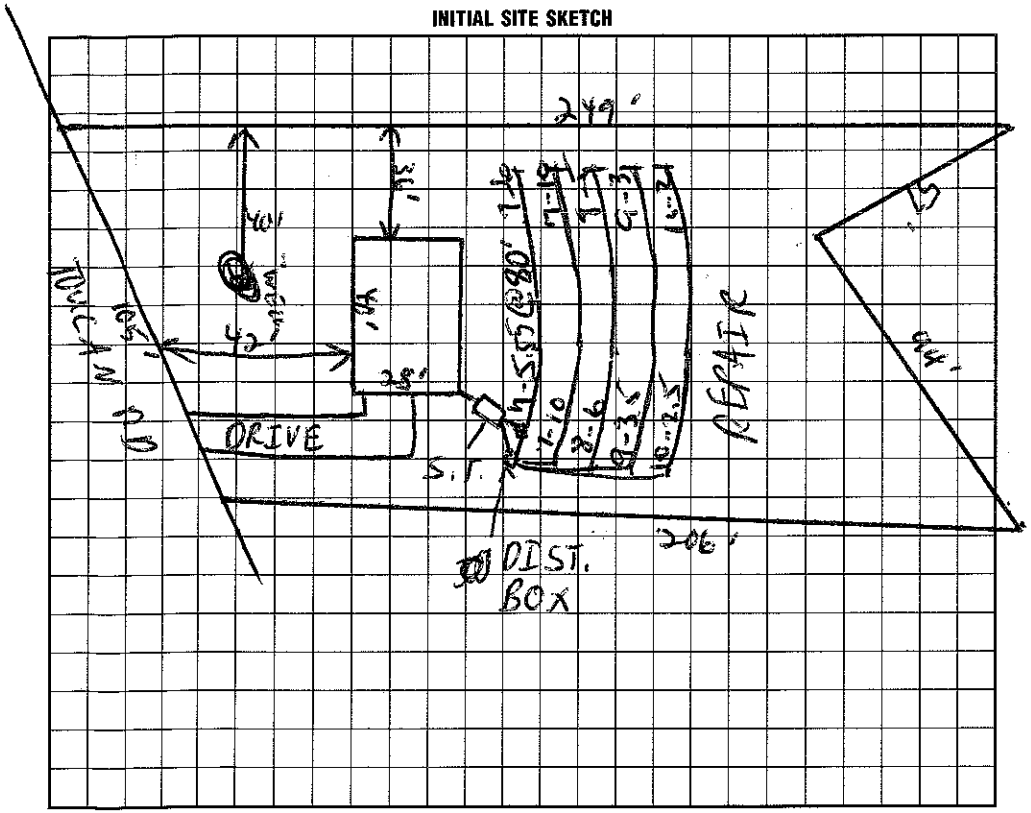

AS BUILT SKETCH

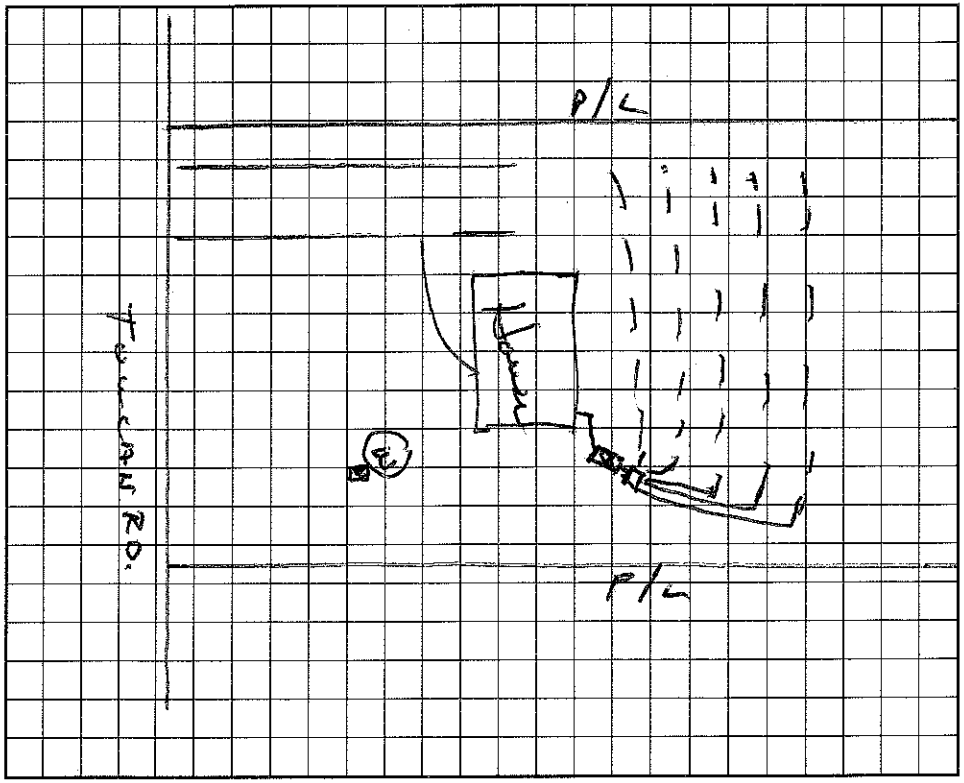

I understand that this permit can be suspended or revoked if any false information is supplied toward securing the permit/any unauthorized changes are made to the site/any unauthorized changes are made in the installation of the system.

Signed: Bill Ball

Improvement Permit by: C. Ray Ferguson EHS date 12/11/96

~~Existing System Inspection by:~~ AUTHORIZATION TO CONSTRUCT C. Ray Ferguson EHS date 12/11/96

Installed by: FJ Ervin

Certificate of Completion by: Wesley Sparks R.S. date 8/27/97

Operation Permit by: Wesley Sparks R.S. date 8/27/97

HEALTH DEPT. COPY: WHITE INSPECTION COPY (FINAL): GREEN OWNER COPY (FINAL): YELLOW INSPECTION COPY (INITIAL): PINK OWNER COPY (INITIAL): GOLD