PIN# 4658-47-1309

AUTHORIZATION TO CONSTRUCT

(1:30)

IREDELL COUNTY HEALTH DEPARTMENT

STATESVILLE 704-878-5305 MOORESVILLE 704-664-5281

IMPROVEMENT PERMIT / ~~CERTIFICATE OF COMPLETION~~ / OPERATION PERMIT / EXISTING SYSTEM INSPECTION

PROPERTY DESCRIPTION NO. 25540 DATE 11/20/96 TAX MAP NO. 1R-A-9 & 10pt of Watershed: ☑ Yes ☐ No

OWNER OR CONTRACTOR ROBERT PHILLIPS PHONE: Business _____ Home 873-6154

ADDRESS 1852 D SIMON ST STATESVILLE NC 28677

LOCATION 115S, TR US 21, TR BAILEY RD, TR TOUCAN RD, AT CORNER OF ~~LOT~~. WHEN ON LEFT

SUBDIVISION FARMDALE BLOCK / SECTION II LOT 24 LOT AREA _____ SITE CLASS. B5 DESIGN FLOW 360 GPD L.T.A.R. .3 GPD/FT

Septic Tank: 600 Gallons; STB 825 Date 2/3/97

Pump Tank: _____ Gallons; PT _____ Date _____

Pump Make: _____ Model _____ Serial No. _____

Nitrification Field: No Fields 1 Square Feet 900 Linear Feet 300

No Lines 5 Trench Width 36" Max Trench Bottom Depth 30" Gravel Depth N/A

☑ New System ☐ Repair System Type: I, II, III, IV, V, VI

System Description: GRAVITY CHAMBERED

Repair System Description: PANEL

Maintenance Agreement Required: ☐ Yes ☑ No

☑ House/Mod. Home No. Bedrooms 3

☐ Mobile Home No. Bathrooms 2

☐ Business No. Employees _____

☐ Other _____


☐ Slab ☑ Crawl Space ☐ Basement w/plumbing ☐ Basement wo/plumbing

Water Supply:
☑ Individual
☐ Community
☐ Public

Comments:

Comments:

INITIAL SITE SKETCH

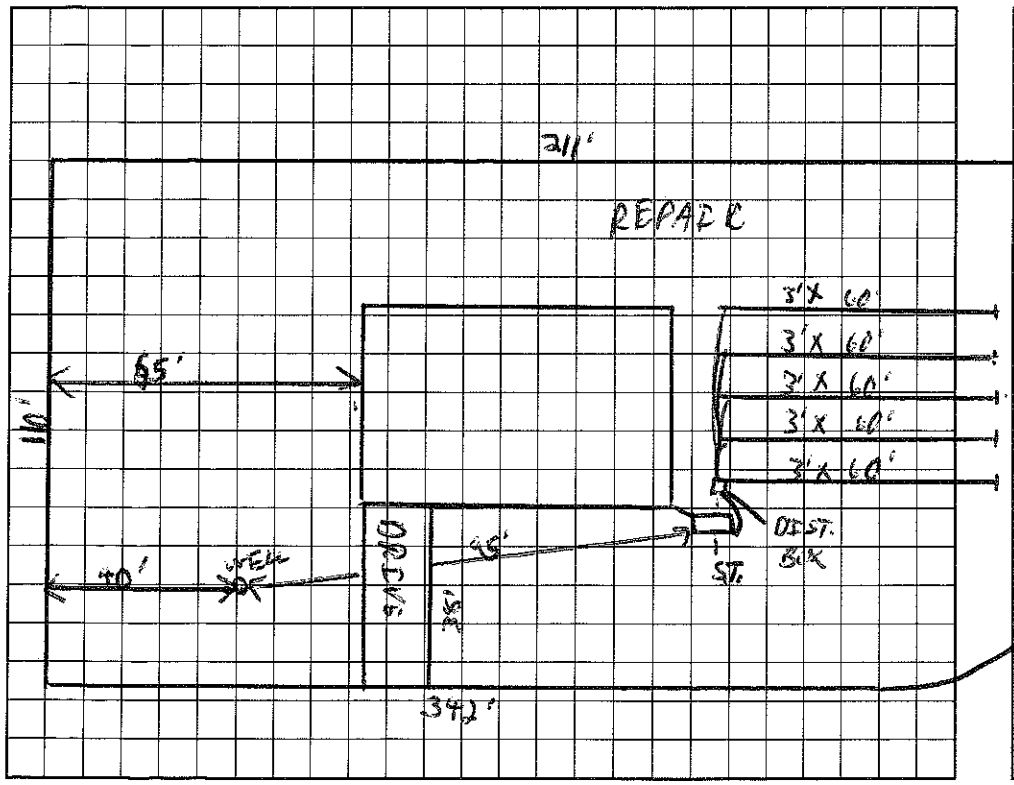

AS BUILT SKETCH

Same as Site Sketch

I understand that this permit can be suspended or revoked if any false information is supplied toward securing the permit/any unauthorized changes are made to the site/any unauthorized changes are made in the installation of the system.

Signed: Robert D Phillips

Improvement Permit by: C. [illegible] date 11/20/96

AUTHORIZATION TO CONSTRUCT ~~Existing System Inspection by~~: C. [illegible] date 11/20/96

Installed by: DELBERT BOSTIAN

Certificate of Completion by: _____ date _____

Operation Permit by: C. [illegible] date 3/26/97

HEALTH DEPT. COPY: WHITE INSPECTION COPY (FINAL): GREEN OWNER COPY (FINAL): YELLOW INSPECTION COPY (INITIAL): PINK OWNER COPY (INITIAL): GOLD