IREDELL COUNTY HEALTH DEPARTMENT

Authorization To Construct

STATESVILLE 704-878-5305 MOORESVILLE 704-664-5281

IMPROVEMENT PERMIT / ~~CERTIFICATE OF COMPLETION~~ / OPERATION PERMIT / EXISTING SYSTEM INSPECTION

PROPERTY DESCRIPTION NO. 067042 DATE 5/20/97 TAX MAP NO. 4658471860 Watershed: [X] Yes [ ] No

OWNER OR CONTRACTOR Bill Hunter PHONE: Business _____ Home 664-8088

ADDRESS 626 Heatherly Rd. Mooresville, NC. 28115

LOCATION Toucan Rd. to 9th lot on (R)

SUBDIVISION Fernvale BLOCK / SECTION II LOT 14 LOT AREA .51 SITE CLASS. PS DESIGN FLOW 360 L.T.A.R. .3

Septic Tank: 1000 Gallons; STB 1012 Date 6/20/98

Pump Tank: _____ Gallons; PT _____ Date _____

Pump Make: _____ Model _____ Serial No. _____

Nitrification Field: No Fields 1 Square Feet 900* Linear Feet 300*

No Lines 4 Trench Width 36" Max Trench Bottom Depth 30" Gravel Depth SAND.

[X] New System [ ] Repair System Type: I, II, (III) IV, V, VI

System Description: GRAV-CH PLASTIC

Repair System Description: SAME

Maintenance Agreement Required: [ ] Yes [X] No

[X] House/Mod. Home No. Bedrooms 3

[ ] Mobile Home No. Bathrooms 2

[ ] Business No. Employees _____

[ ] Other _____


[ ] Slab [X] Crawl Space [ ] Basement w/plumbing [ ] Basement wo/plumbing

Water Supply: [X] Individual [ ] Community [ ] Public


Comments:

Comments:

INITIAL SITE SKETCH

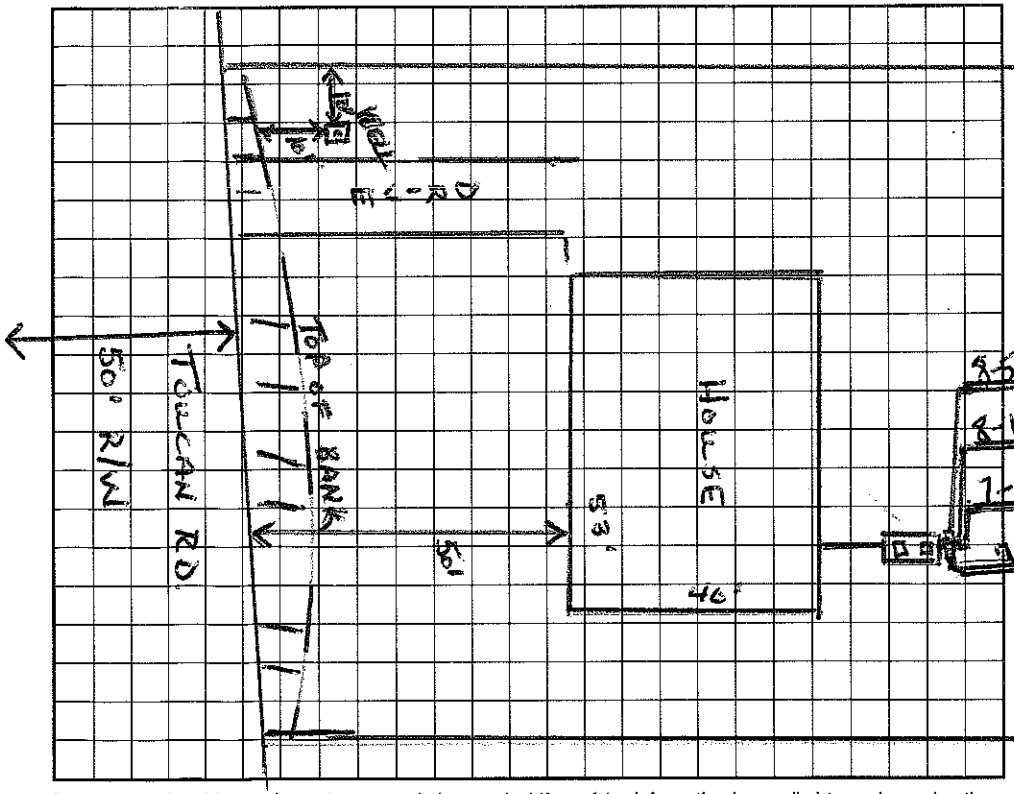

AS BUILT SKETCH

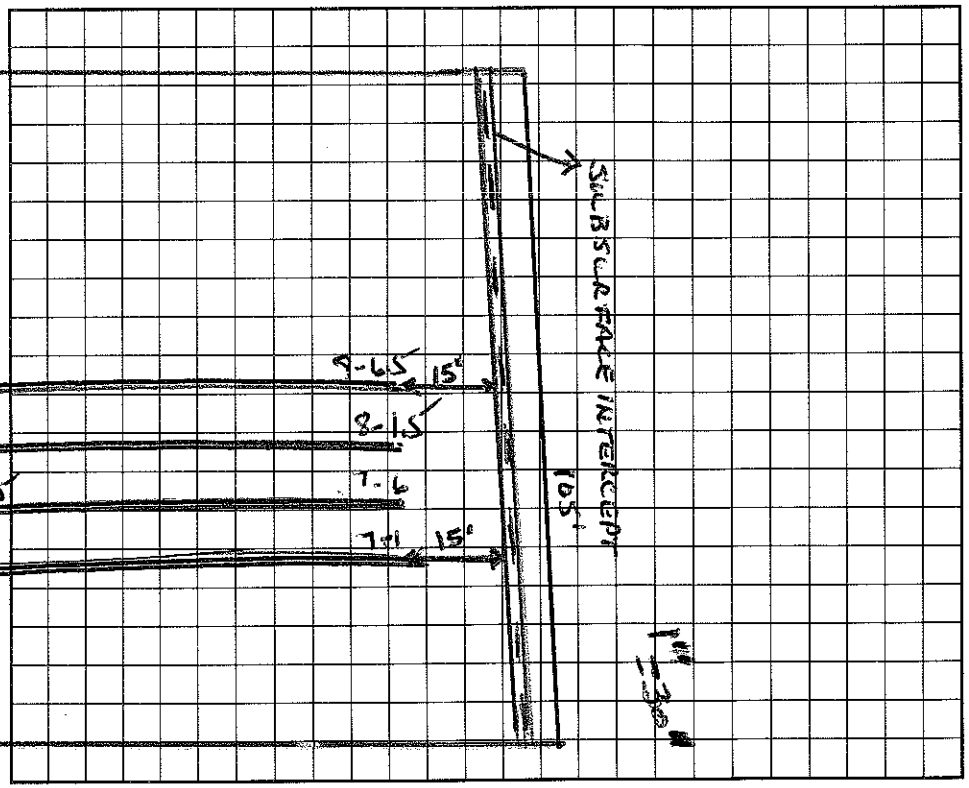

I understand that this permit can be suspended or revoked if any false information is supplied toward securing the permit/any unauthorized changes are made to the site/any unauthorized changes are made in the installation of the system. Improvement Permit is valid for 60 months from date of issuance.

Signed: X Bill Ball

Improvement Permit by: Wesley Sparks R.S. date 5/20/97

Existing System Inspection by: Wesley Sparks R.S. date 5/20/97

Installed by: Forest Shuford

Certificate of Completion by: _____ date _____

Operation Permit by: Wesley Sparks R.S. date 8/14/98

HEALTH DEPT. COPY: WHITE INSPECTION COPY (FINAL): GREEN OWNER COPY (FINAL): YELLOW INSPECTION COPY (INITIAL): PINK OWNER COPY (INITIAL): GOLD