IREDELL COUNTY HEALTH DEPARTMENT

Authorization to Construct

STATESVILLE 704-878-5305 MOORESVILLE 704-664-5281

IMPROVEMENT PERMIT / ~~CERTIFICATE OF COMPLETION~~ / OPERATION PERMIT / EXISTING SYSTEM INSPECTION

PROPERTY DESCRIPTION NO. 66071 DATE 8/5/97 TAX MAP NO. 4658 47 19 41 Watershed: ☒ Yes ☐ No

OWNER OR CONTRACTOR James & Donna Olsen PHONE: Business BILL BALL - 244-0264 Home

ADDRESS

LOCATION Bailey Rd. TR Toward to 10th on (R)

SUBDIVISION Farmdale BLOCK / SECTION II LOT 15 LOT AREA .59 Ac SITE CLASS. PS DESIGN FLOW 360 L.T.A.R. .3

Septic Tank: 1000 Gallons; STB 825 Date 10/24/97

Pump Tank: Gallons; PT Date

Pump Make: Model Serial No.

Nitrification Field: No Fields 1 Square Feet * 900 Linear Feet * 300

No Lines 4 Trench Width 36" Max Trench Bottom Depth 36" Gravel Depth SAND

☒ New System ☐ Repair System Type: I, II, (III) IV, V, VI

System Description: GRAV - CH PLASTIC

Repair System Description: SAME

Maintenance Agreement Required: ☐ Yes ☒ No

☒ House/Mod. Home ☐ Mobile Home ☐ Business ☐ Other

No. Bedrooms 3 No. Bathrooms 2 No. Employees

☐ Slab ☒ Crawl Space ☐ Basement w/plumbing ☐ Basement wo/plumbing


Water Supply: ☐ Individual ☐ Community ☐ Public

Comments: * 25% reduction for use of Chamberd Plastic Disinfield


* 8/14/97 Changed S/T location to avoid sewer grading problems. AMB

Comments:

INITIAL SITE SKETCH

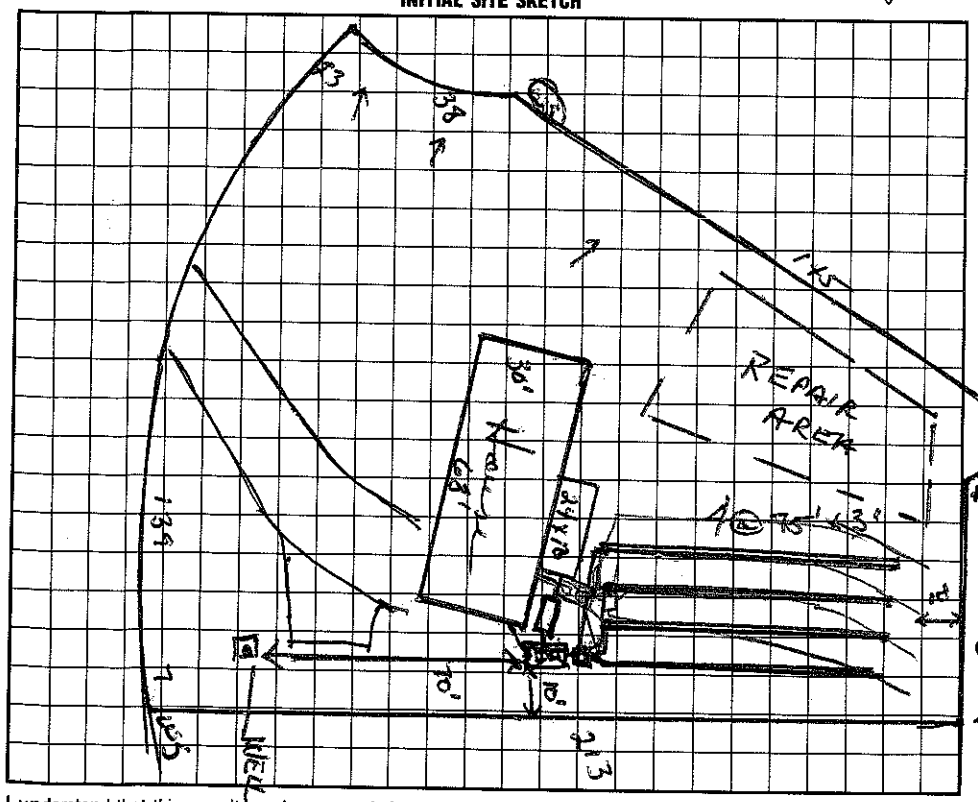

AS BUILT SKETCH

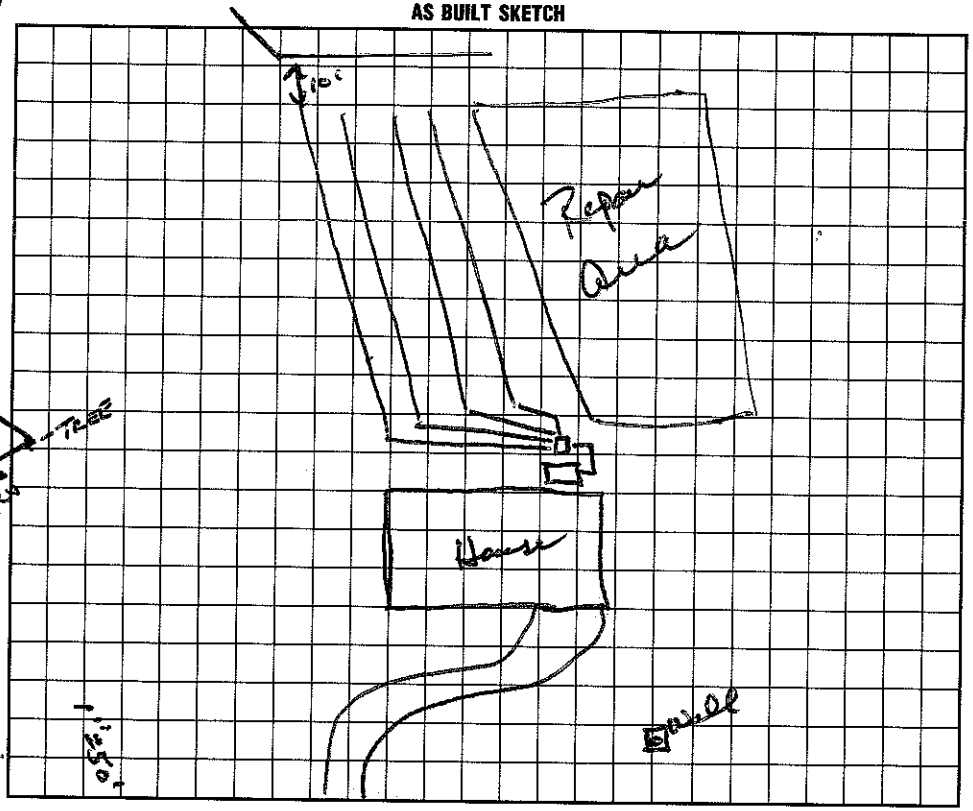

I understand that this permit can be suspended or revoked if any false information is supplied toward securing the permit/any unauthorized changes are made to the site/any unauthorized changes are made in the installation of the system. Improvement Permit is valid for 60 months from date of issuance.

Signed: * Bill Ball

Improvement Permit by: Wesley Sparks RS. date 8/5/97

Existing System Inspection by: Wesley Sparks RS. date 8/5/97

Installed by: Piedmont Septic Tank

Certificate of Completion by: Wesley Sparks RS. date 12/4/97

Operation Permit by: Wesley Sparks RS. date 12/4/97

HEALTH DEPT. COPY: WHITE INSPECTION COPY (FINAL): GREEN OWNER COPY (FINAL): YELLOW INSPECTION COPY (INITIAL): PINK OWNER COPY (INITIAL): GOLD