IREDELL COUNTY HEALTH DEPARTMENT

Authorization to Construct

4658471941

STATESVILLE 704-878-5305 MOORESVILLE 704-664-5281

IMPROVEMENT PERMIT / CERTIFICATE OF COMPLETION / OPERATION PERMIT / EXISTING SYSTEM INSPECTION

PROPERTY DESCRIPTION NO. Repair DATE 4/15/96 TAX MAP NO. N/A Watershed: ☒ Yes ☐ No

OWNER OR CONTRACTOR James Olsen PHONE: Business Home 662-0172

ADDRESS 337 Whippoorwill Rd. Mooresville NC. 28115

LOCATION top end of Whippoorwill Rd. Go to gravel to first house on (L)

SUBDIVISION No BLOCK / SECTION LOT LOT AREA SITE CLASS. DESIGN FLOW L.T.A.R.

Septic Tank: Existing Gallons; STB Date

Pump Tank: Gallons; PT Date

Pump Make: Model Serial No.

Nitrification Field: No Fields 1 Square Feet 480 Linear Feet 120

No Lines 2 Trench Width 8' Max Trench Bottom Depth 36" Gravel Depth 12-14"

☐ New System ☒ Repair System Type: I (II) III. IV. V. VI

System Description: Bed for washing machine

Repair System Description:

Maintenance Agreement Required: ☐ Yes ☒ No

☒ House/Mod. Home No. Bedrooms 3

☐ Mobile Home No. Bathrooms 2.5

☐ Business No. Employees

☐ Other


☐ Slab ☐ Crawl Space ☒ Basement w/plumbing ☐ Basement wo/plumbing

Water Supply: ☒ Individual ☐ Community ☐ Public

Comments:

Comments:

INITIAL SITE SKETCH

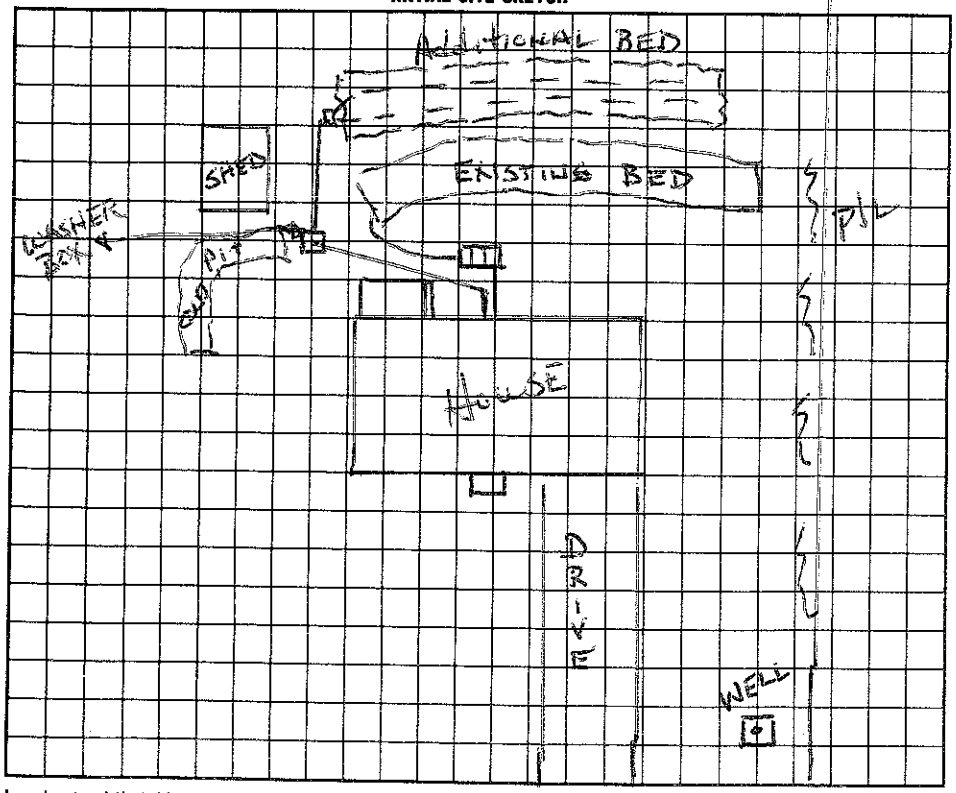

AS BUILT SKETCH

I understand that this permit can be suspended or revoked if any false information is supplied toward securing the permit/any unauthorized changes are made to the site/any unauthorized changes are made in the installation of the system.

Signed:

Improvement Permit by: date

Existing System Inspection by: Contract: Wesley Sparks date 4/15/96

Installed by: Curt Dunning

Certificate of Completion by: date

Operation Permit by: Wesley Sparks RS date 6/6/96

HEALTH DEPT. COPY: WHITE INSPECTION COPY (FINAL): GREEN OWNER COPY (FINAL): YELLOW INSPECTION COPY (INITIAL): PINK OWNER COPY (INITIAL): GOLD