IREDELL COUNTY HEALTH DEPARTMENT

AUTHORIZATION TO CONSTRUCT

PIN# 4658-47-2491

STATESVILLE 704-878-5305 MOORESVILLE 704-664-5281

IMPROVEMENT PERMIT / ~~CERTIFICATE OF COMPLETION~~ / OPERATION PERMIT / EXISTING SYSTEM INSPECTION

PROPERTY DESCRIPTION NO. 25704 DATE 12/10/96 TAX MAP NO. 1R-A-9 + 10 pt of Watershed: ☑ Yes ☐ No

OWNER OR CONTRACTOR BILL BALL PHONE: Business 244-0264 Home

ADDRESS RT #2, BOX 307-A HIDDENITE

LOCATION ~~HIDDEN~~ 21N - TR BAILEY RD, TR TOUCAN RD LOT ON RT

SUBDIVISION FARMDALE BLOCK / SECTION II LOT 10 LOT AREA .5 AC SITE CLASS. PS DESIGN FLOW 360 GPD L.T.A.R. .36 GPD/FT²

Septic Tank: 1000 Gallons; STB 1012 Date 7/10/96

Pump Tank: Gallons; PT Date

Pump Make: Model Serial No.

Nitrification Field: No Fields 1 Square Feet 1200 Linear Feet 400

No Lines 4 Trench Width 36" Max Trench Bottom Depth 24" Gravel Depth 12"

☑ New System ☐ Repair System Type: I, (II), III, IV, V, VI

System Description: GRAVITY CONVENTIONAL

Repair System Description: PUMP PANEL

Maintenance Agreement Required: ☐ Yes ☑ No

☑ House/Mod. Home No. Bedrooms 3

☐ Mobile Home No. Bathrooms 2

☐ Business No. Employees

☐ Other


☐ Slab ☑ Crawl Space ☐ Basement w/plumbing ☐ Basement wo/plumbing

Water Supply: ☑ Individual ☐ Community ☐ Public


Comments:

Comments:

INITIAL SITE SKETCH 1"=40'

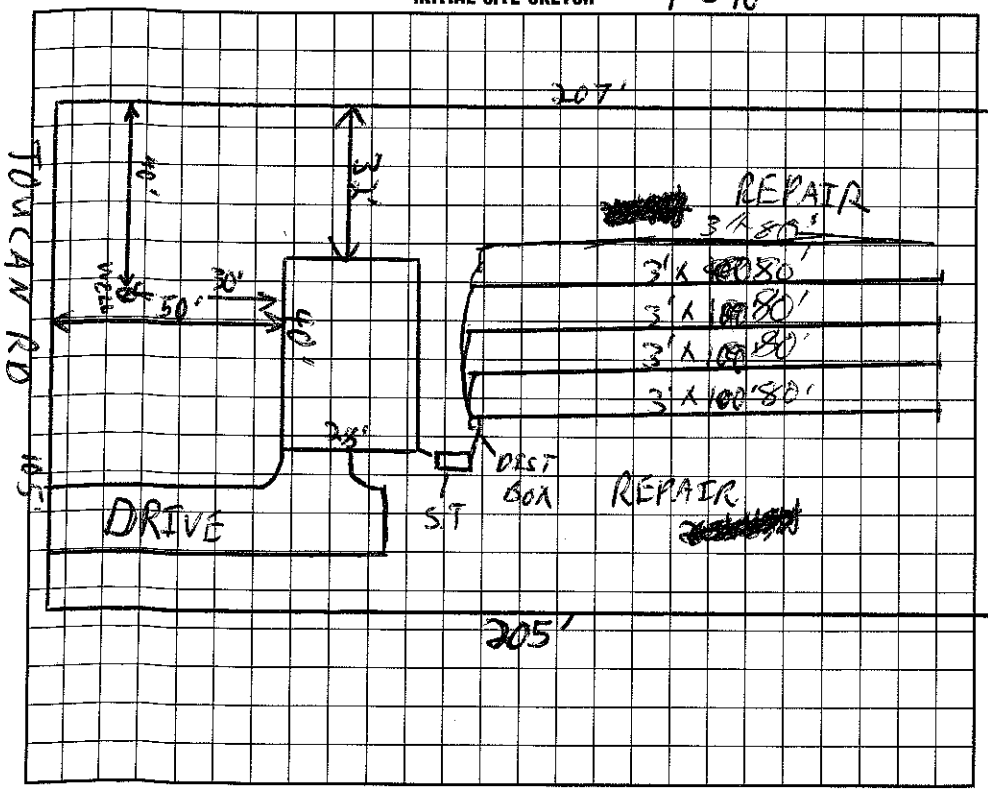

AS BUILT SKETCH

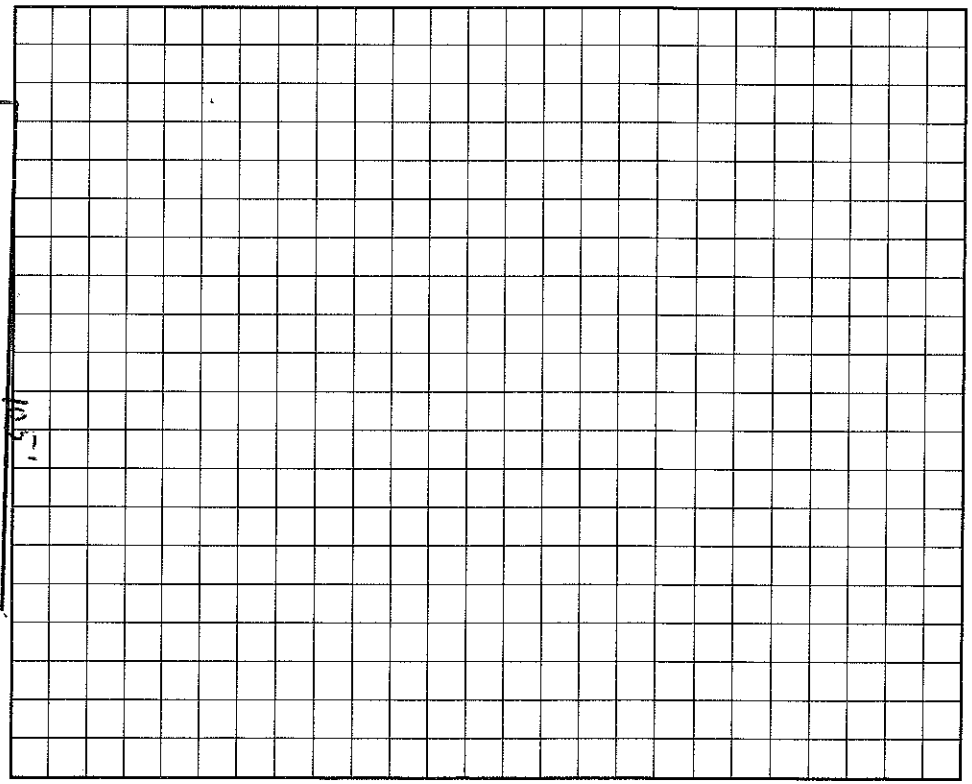

I understand that this permit can be suspended or revoked if any false information is supplied toward securing the permit/any unauthorized changes are made to the site/any unauthorized changes are made in the installation of the system.

Signed: Bill Ball

Installed by: FOREST SDUFORD

Improvement Permit by: C. Robert Thomas EHSI date 12/10/96

AUTHORIZATION TO CONSTRUCT Existing System Inspection by: C. Robert Thomas EHSI date 12/10/96

Certificate of Completion by: date

Operation Permit by: C. Robert Thomas RS date 12/18/96

HEALTH DEPT. COPY: WHITE INSPECTION COPY (FINAL): GREEN OWNER COPY (FINAL): YELLOW INSPECTION COPY (INITIAL): PINK OWNER COPY (INITIAL): GOLD