# IREDELL COUNTY HEALTH DEPARTMENT — Authorization to Construct

STATESVILLE 704-878-5305 MOORESVILLE 704-664-5281

## IMPROVEMENT PERMIT / ~~CERTIFICATE OF COMPLETION~~ / OPERATION PERMIT / EXISTING SYSTEM INSPECTION

PROPERTY DESCRIPTION NO. 066803 DATE 5/5/97 TAX MAP NO. 4658472560 Watershed: [X] Yes [ ] No

OWNER OR CONTRACTOR E. Lynn Tatum PHONE: Business 664-7392 Home

ADDRESS 382 Templeton Rd. Mooresville, NC. 28115 PIN# 4658-47-2560

LOCATION 21N TL Bailey Rd. TR Toucan Rd. to 5th lot on (R)

SUBDIVISION FARMDALE BLOCK / SECTION II LOT 111 LOT AREA .51 SITE CLASS. PS DESIGN FLOW 360 L.T.A.R. .3

Septic Tank: 1000 Gallons; STB 825 Date 8-2-98
Pump Tank: ____ Gallons; PT ____ Date ____
Pump Make: ____ Model ____ Serial No. ____
Nitrification Field: No Fields 1 Square Feet 1200 Linear Feet 400
No Lines 5 Trench Width 36" Max Trench Bottom Depth 30" Gravel Depth 12"

[X] New System [ ] Repair System Type: I, II, III, IV, V, VI
System Description: CONV - DROP BOX
Repair System Description: PLASTIC CHS.
Maintenance Agreement Required: [ ] Yes [X] No

[X] House/Mod. Home No. Bedrooms 3
[ ] Mobile Home No. Bathrooms 2
[ ] Business No. Employees ____
[ ] Other ____


[ ] Slab [X] Crawl Space [ ] Basement w/plumbing [ ] Basement wo/plumbing

Water Supply: [X] Individual [ ] Community [ ] Public


Comments:

Comments:

**INITIAL SITE SKETCH**

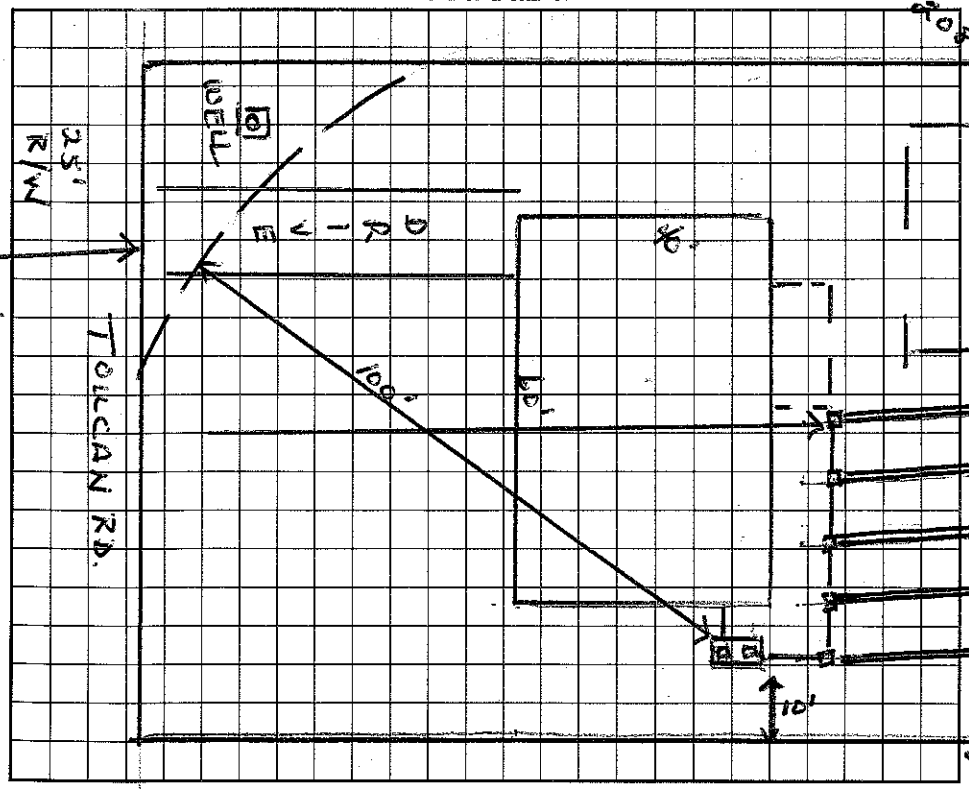


**AS BUILT SKETCH**

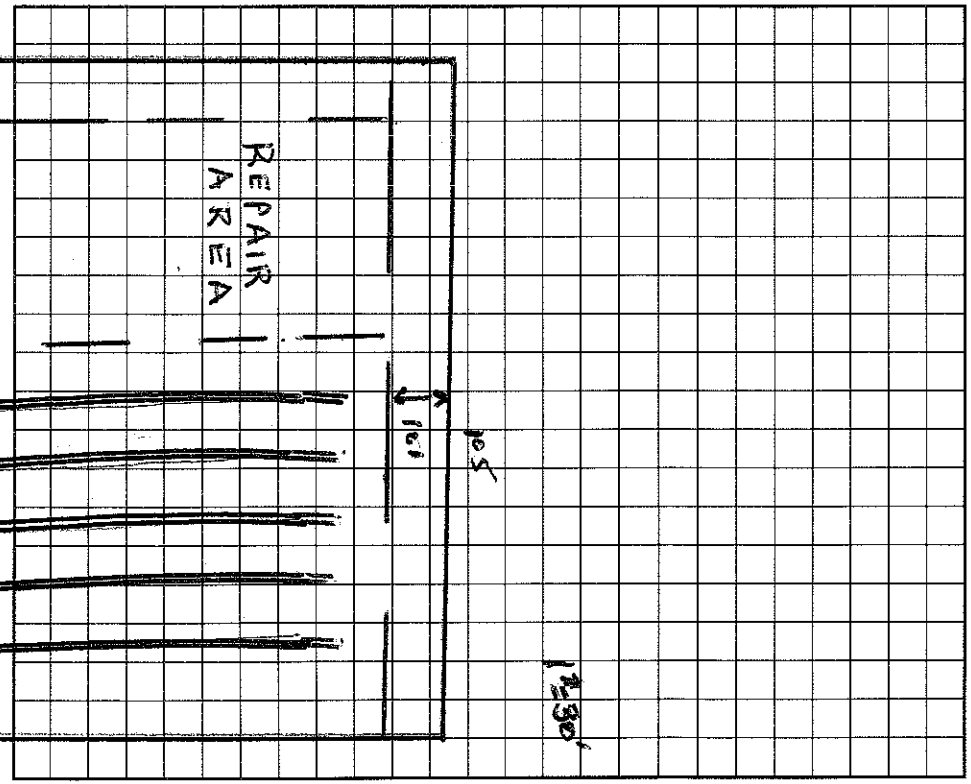


I understand that this permit can be suspended or revoked if any false information is supplied toward securing the permit/any unauthorized changes are made to the site/any unauthorized changes are made in the installation of the system. Improvement Permit is valid for 60 months from date of issuance.

Signed: X [illegible] for E. Tatum

Installed by: Delbert Benton

Improvement Permit by: Wesley Sparks R.S. date 5/5/97

Certificate of Completion by: Wesley Sparks R.S. date 9/16/98

Existing System Inspection by: Wesley Sparks R.S. date 5/5/97

Operation Permit by: Wesley Sparks R.S. date 9/16/98

HEALTH DEPT. COPY: WHITE / INSPECTION COPY (FINAL): GREEN / OWNER COPY (FINAL): YELLOW / INSPECTION COPY (INITIAL): PINK / OWNER COPY (INITIAL): GOLD