PIN# 4658-47-2630

Authorization to Construct

4:00

IREDELL COUNTY HEALTH DEPARTMENT

STATESVILLE 704-878-5305 MOORESVILLE 704-664-52[illegible]

IMPROVEMENT PERMIT / ~~CERTIFICATE OF COMPLETION~~ / OPERATION PERMIT / EXISTING SYSTEM INSPECTION

PROPERTY DESCRIPTION NO. 67045 DATE 5/20/97 TAX MAP NO. 4658472630 Watershed: X Yes ☐ No

OWNER OR CONTRACTOR Bill Hunter PHONE: Business _____ Home 664-8088

ADDRESS 626 Heatherly Rd Mooresville, NC. 28115

LOCATION 21/115 N TL Bailey Rd. TR Toucan on Rt. to 6th lot.

SUBDIVISION FARMDALE BLOCK / SECTION 2 LOT 12 LOT AREA .51 SITE CLASS. PS DESIGN FLOW 360 L.T.A.R. .3

Septic Tank: 1000 Gallons; STB 825 Date _____

Pump Tank: _____ Gallons; PT _____ Date _____

Pump Make: _____ Model _____ Serial No. _____

Nitrification Field: No Fields 1 Square Feet ~~900~~ Linear Feet ~~300~~

No Lines 4 Trench Width 36" Max Trench Bottom Depth 32" Gravel Depth SAND

X New System ☐ Repair System Type: I, II, (III), IV, V, VI

System Description: Drop-ch Plastic

Repair System Description: Same

Maintenance Agreement Required: ☐ Yes ☐ No

X House/Mod. Home No. Bedrooms 3

☐ Mobile Home No. Bathrooms 2

☐ Business No. Employees _____

☐ Other _____


☐ Slab X Crawl Space ☐ Basement w/plumbing ☐ Basement wo/plumbing

Water Supply: X Individual ☐ Community ☐ Public


Comments:

Comments:

INITIAL SITE SKETCH

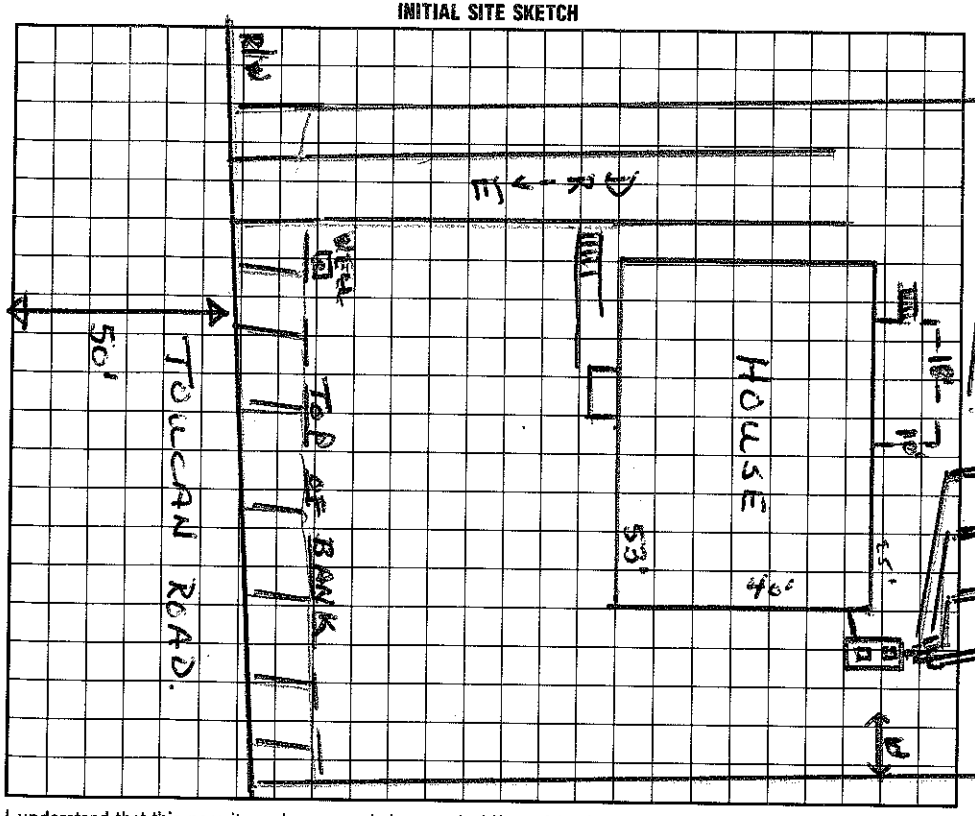

AS BUILT SKETCH

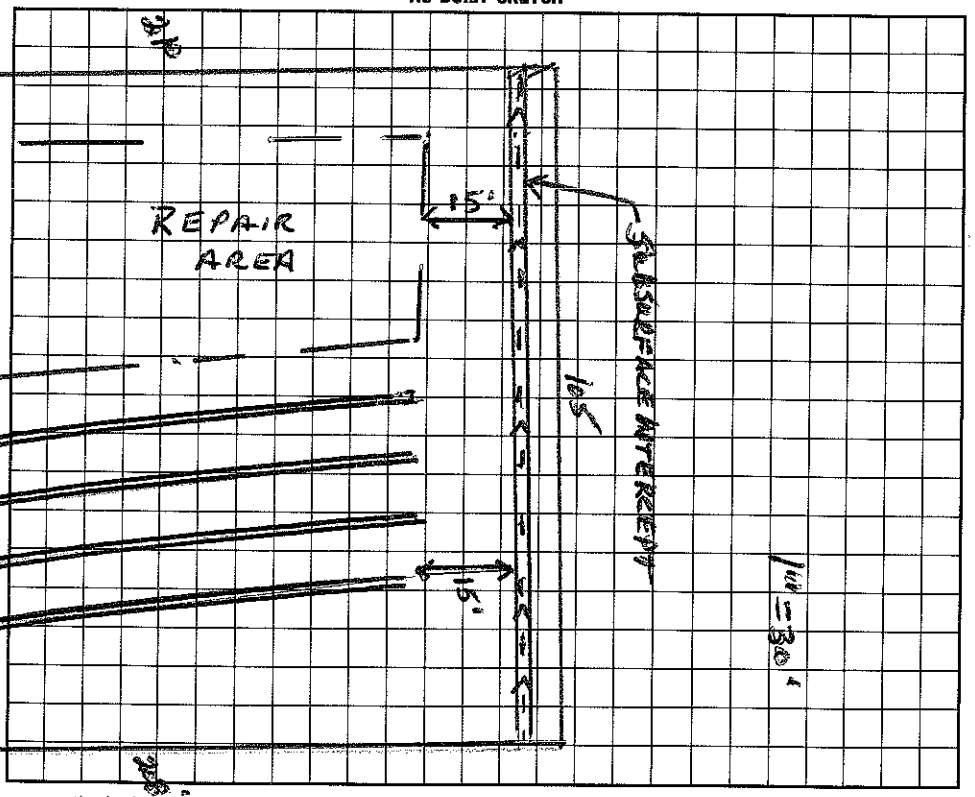

I understand that this permit can be suspended or revoked if any false information is supplied toward securing the permit/any unauthorized changes are made to the site/any unauthorized changes are made in the installation of the system. Improvement Permit is valid for 60 months from date of issuance.

Signed: ~~X~~ Bill Ball

Improvement Permit by: Wesley Sparks RS. date 5/20/97

~~Authorization to Construct~~ Existing System Inspection by: Wesley Sparks RS. date 5/20/97

Installed by: Piedmont Septic Tank

Certificate of Completion by: Wesley Sparks RS. date 10/3/97

Operation Permit by: Wesley Sparks RS. date 10/3/97

HEALTH DEPT. COPY: WHITE INSPECTION COPY (FINAL): GREEN OWNER COPY (FINAL): YELLOW INSPECTION COPY (INITIAL): PINK OWNER COPY (INITIAL): GOLD