IREDELL COUNTY HEALTH DEPARTMENT

Authorization to Construct

STATESVILLE 704-878-5305 MOORESVILLE 704-664-5281

IMPROVEMENT PERMIT / ~~CERTIFICATE OF COMPLETION~~ / OPERATION PERMIT / EXISTING SYSTEM INSPECTION

PROPERTY DESCRIPTION NO. 066802 DATE 5/5/97 TAX MAP NO. 4658473331 Watershed: [X] Yes [ ] No

OWNER OR CONTRACTOR ~~Bobby Hayworth~~ Butch Tate PHONE: Business 663-3989 Home

ADDRESS 136 Fairway Dr Mooresville, NC 28115

LOCATION 2 IN TL Bailey Rd, TR Toucan on (R) at top of hill, 3rd lot on (R)

SUBDIVISION FAIRDALE BLOCK / SECTION II LOT 9 LOT AREA .5 SITE CLASS. PS DESIGN FLOW 360 L.T.A.R. .55

Septic Tank: 1000 Gallons; STB 525 Date 7/11/98

Pump Tank: 1000 Gallons; PT 47 Date 6/28/98

Pump Make: Model Serial No.

Nitrification Field: No Fields 1 Square Feet 1068* Linear Feet 360*

No Lines 4 Trench Width 36" Max Trench Bottom Depth 30" Gravel Depth ~~STND~~

[X] New System [ ] Repair System Type: I, II, (III), IV, V, VI

System Description: PRESMAN ~~CH. PLASTIC~~

Repair System Description: 16"PPBS

Maintenance Agreement Required: [ ] Yes [X] No

[X] House/Mod. Home No. Bedrooms 3

[ ] Mobile Home No. Bathrooms 2

[ ] Business No. Employees

[ ] Other


[ ] Slab [X] Crawl Space [ ] Basement w/plumbing [ ] Basement wo/plumbing

Water Supply: [X] Individual [ ] Community [ ] Public


Comments: 4@65" x 3' install on contour

Comments:

INITIAL SITE SKETCH

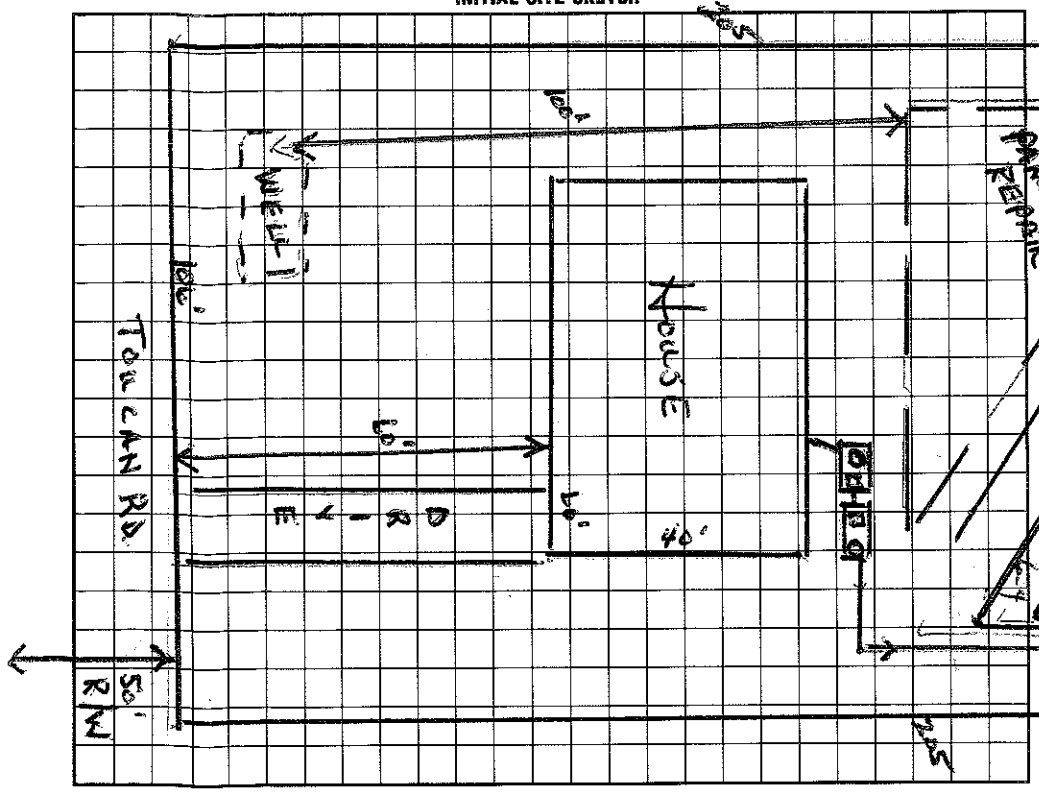

AS BUILT SKETCH

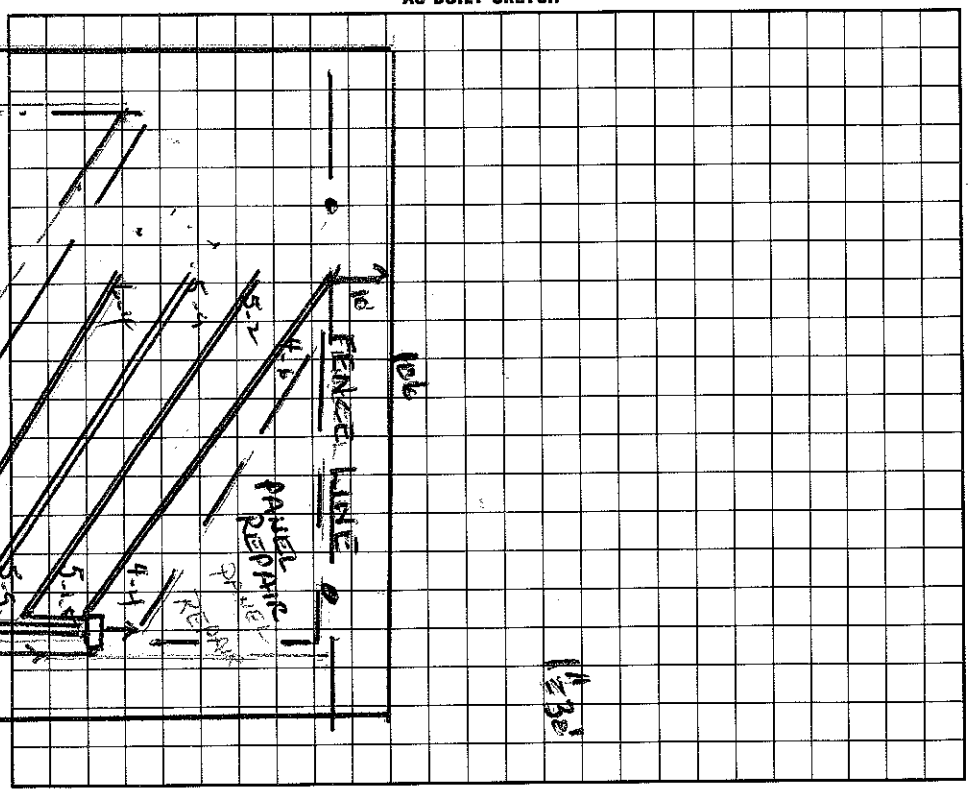

I understand that this permit can be suspended or revoked if any false information is supplied toward securing the permit/any unauthorized changes are made to the site/any unauthorized changes are made in the installation of the system. Improvement Permit is valid for 60 months from date of issuance.

Signed: X

Improvement Permit by: Wesley Sparks RS. date 5/5/97

Final Inspection by: Wesley Sparks RS. date 5/5/97

Installed by: Delbert Bostian

Certificate of Completion by: date

Operation Permit by: RS date 11/3/98

HEALTH DEPT. COPY: WHITE INSPECTION COPY (FINAL): GREEN OWNER COPY (FINAL): YELLOW INSPECTION COPY (INITIAL): PINK OWNER COPY (INITIAL): GOLD