IREDELL COUNTY HEALTH DEPARTMENT

STATESVILLE 704-878-5305 MOORESVILLE 704-664-5281

IMPROVEMENT PERMIT / AUTHORIZATION TO CONSTRUCT / OPERATION PERMIT / EXISTING SYSTEM INSPECTION

PERMIT # 160832 PIN # 4658482146 DATE 5-27-2010

OWNER or APPLICANT Lynna Teresa Lyasham PHONE: Business 7045960361 Home: 704 660-0680

OWNER or APPLICANT ADDRESS 180 Toucan Rd Mooresville NC

LOCATION / DIRECTIONS Hwy 21 N TL Bailey Rd TR Toucan Rd at end

SUBDIVISION Farmdale BLOCK / SECTION II LOT # LOT AREA 9.88Ac DESIGN FLOW 480gpd T.A.R. .3

Exist. Septic Tank 1000 Gallons: STB Date

Pump Tank Gallons: P T Date

Pump Make Model Serial #

Exist. Nitrification Field No Fields 1 No Lines 4 Linear Feet 533'

Trench Width 36" Max. Trench Bottom Depth 36" Gravel Depth

☐ New System ☐ Repair ☐ Expansion System Type I ☒ II III IV V VI

System Description: Existing Gravity-Conventional

Repair System Description: Same

Maintenance Agreement Required ☐ YES ☒ NO

☒ GRAVITY ☐ PRESSURE

☒ Residence No. Bedrooms 4

☐ Business No. Persons

☐ Other No. Employees

☐ Slab ☐ Crawl Space


☐ Basement w/plumbing ☐ Basement w/o plumbing

Water Supply: ☒ Private ☐ Public ☐ Community

Comments / Conditions ☆ Not to Scale.

Comments / Conditions Existing Septic System appears to be functioning okay at time of Inspection. Addition of Accessory Building should not impact Septic System.

INITIAL SITE SKETCH

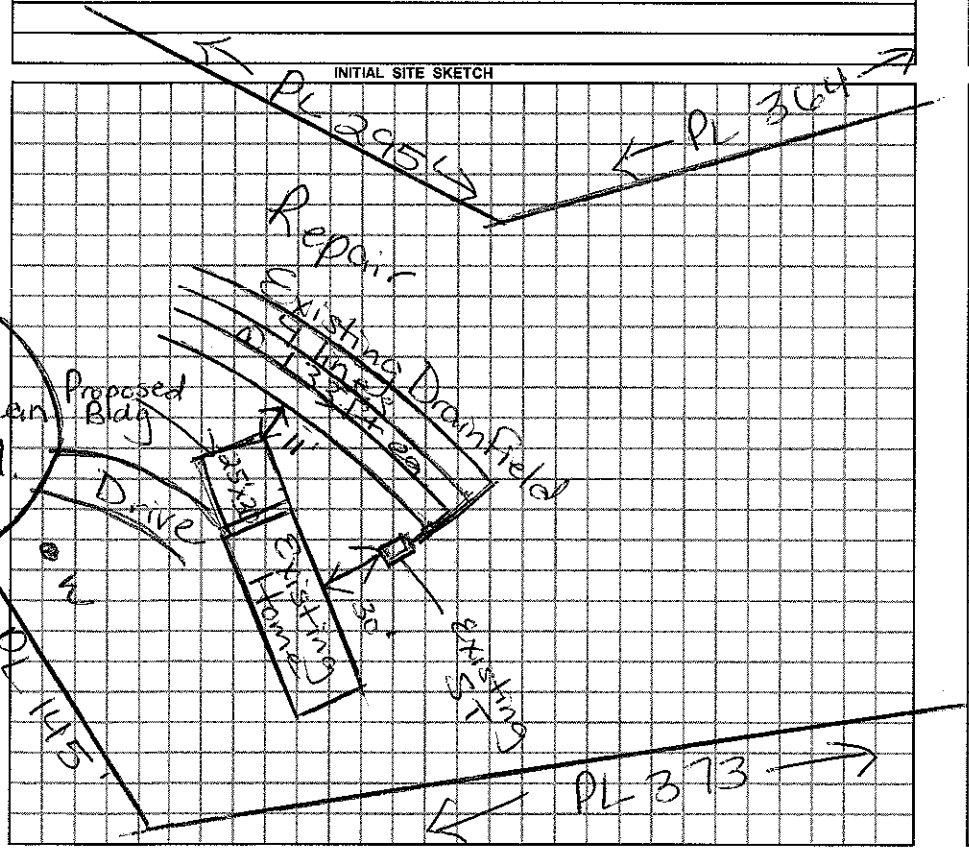

AS BUILT SKETCH

Must keep Accessory Building at least 5ft from Septic System

Permit can be suspended or revoked if any false information is supplied toward securing the permit / any unauthorized changes are made to the site / any unauthorized changes are made in the installation of the system.

☐ *IMPROVEMENT PERMIT w / plat valid without expiration.* ☐ *IMPROVEMENT PERMIT w / site plan valid for 60 mos.* ☐ *AUTHORIZATION TO CONSTRUCT valid for period equal to IMPROVEMENT PERMIT-not to exceed 60 mo.*

Owner / Applicant Signature: Teresa Washam Date 5-28-10

Improvement Permit by: Date

Authorization to Construct by: Date

YOU SHOULD CONTACT A LOCATOR SERVICE PRIOR TO ANY EXCAVATION.

Installed by:

Operation Permit by: Date:

Existing System Inspected by: Maria Dotson Date: 5/28/2010

WHITE COPY Environmental Health YELLOW COPY (Final) Owner / Applicant PINK COPY (Initial) Owner / Applicant