IREDELL COUNTY HEALTH DEPARTMENT

Authorization to Construct

TESVILLE 704-878-5305 MOORESVILLE 704-664-5281

IMPROVEMENT PERMIT / ~~CERTIFICATE OF COMPLETION~~ / OPERATION PERMIT / EXISTING SYSTEM INSPECTION

PROPERTY DESCRIPTION NO. 067561 DATE 7/1/97 TAX MAP NO. 4658482146 Watershed: X Yes ☐

OWNER OR CONTRACTOR Lynn A Washam PHONE: Business _____ Home 528-3512

ADDRESS PO Box 1232 Mooresville, NC. 28115

LOCATION 21 N TL Bailey Rd. TR Toucan Rd. on R at end of Toucan Rd.

SUBDIVISION Farm Dale BLOCK / SECTION II LOT _____ LOT AREA 9.88 AC SITE CLASS. PS DESIGN FLOW 480 L.T.A.R. .3

Septic Tank: 1000 Gallons; STB 825 Date 5/23/97

Pump Tank: _____ Gallons; PT _____ Date _____

Pump Make: _____ Model _____ Serial No. _____

Nitrification Field: No Fields 1 Square Feet 1600 Linear Feet 533

No Lines 4 Trench Width 36" Max Trench Bottom Depth 36" Gravel Depth _____

X New System ☐ Repair System Type: I, (II), III, IV, V, VI

System Description: DIST BOX → CONVENTIONAL

Repair System Description: SAME

Maintenance Agreement Required: ☐ Yes X No

X House/Mod. Home No. Bedrooms 4

☐ Mobile Home No. Bathrooms 2.5

☐ Business No. Employees _____

☐ Other _____


☐ Slab X Crawl Space ☐ Basement w/plumbing ☐ Basement wo/plumbing

Water Supply: X Individual ☐ Community ☐ Public

Comments:

Comments:

INITIAL SITE SKETCH

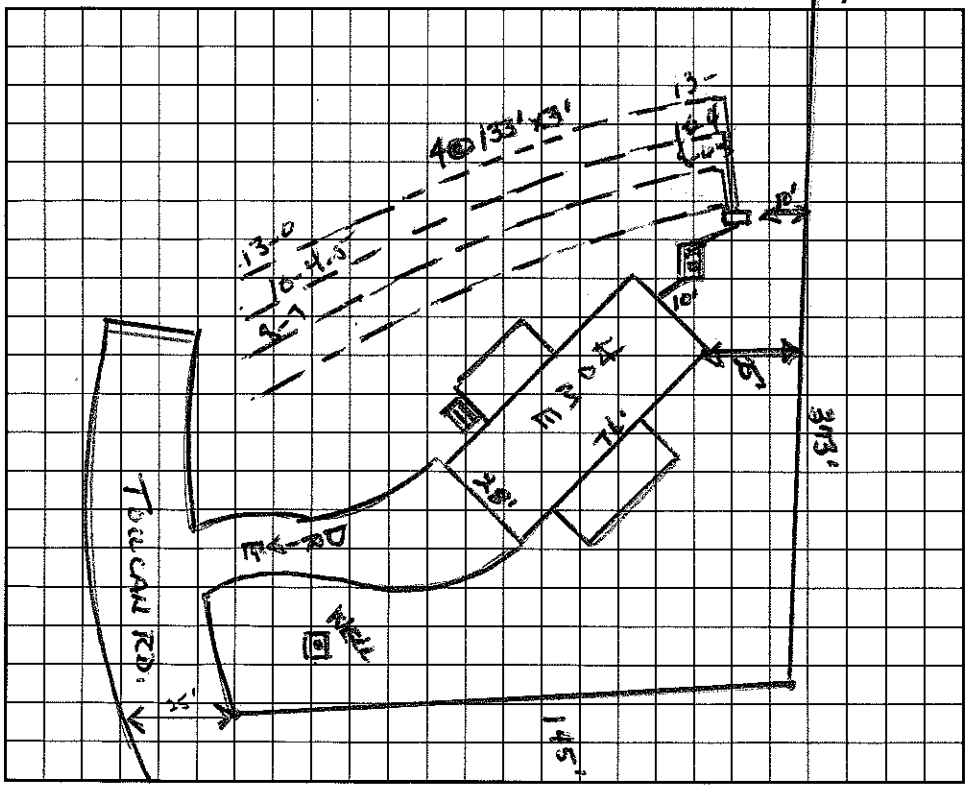

AS BUILT SKETCH

I understand that this permit can be suspended or revoked if any false information is supplied toward securing the permit/any unauthorized changes are made to the site/any unauthorized changes are made in the installation of the system. Improvement Permit is valid for 60 months from date of issuance.

Signed: Teresa Washam

Installed by: Piedmont Septic Tank

Improvement Permit by: Wesley Sparks RS. date 7/1/97

Certificate of Completion by: Wesley Sparks RS. date 8/12/97

Existing System Inspection by: Wesley Sparks RS. date 7/1/97

Operation Permit by: Wesley Sparks RS date 8/7/97

Authorization to Construct

HEALTH DEPT. COPY: WHITE INSPECTION COPY (FINAL): GREEN OWNER COPY (FINAL): YELLOW INSPECTION COPY (INITIAL): PINK OWNER COPY (INITIAL): GOLD