Spruces 26-Sun 54-

IREDELL COUNTY HEALTH DEPARTMENT

STATESVILLE 704-878-5305 MOORESVILLE 704-664-5281

IMPROVEMENT PERMIT / CERTIFICATE OF COMPLETION / OPERATION PERMIT / EXISTING SYSTEM INSPECTION

PROPERTY DESCRIPTION NO. 2139 DATE 11/1/94 TAX MAP NO. 1M11B 26 Watershed: ☑ Yes ☐ No

OWNER OR CONTRACTOR Broadmoore Homes PHONE: Business 663-7660 Home

ADDRESS

LOCATION From Spruce Dr. T.L. on Sun Lane - cul-de-sac on R

SUBDIVISION Sunshine Estates BLOCK / SECTION LOT 26 LOT AREA 1.4 Ac SITE CLASS. P DESIGN FLOW 360 L.T.A.R. .2

Septic Tank 1000 Gallons; STB 825 RST Date 7-12-94

Pump Tank Gallons; PT Date

Pump Make Model Serial No.

Nitrification Field: No Fields 1 Square Feet 1440 Linear Feet 480

No. Lines 6 Trench Width 3' Max Trench Bottom Depth 29" Gravel Depth 12"

☐ New System ☐ Repair System Type: I, ☑ II, III, IV, V, VI

System Description: CONV - DROP BOXES

Repair System Description: GRAVITY PANEL 16"

Maintenance Agreement Required: ☐ Yes ☑ No

☑ House/Mod. Home ☐ Mobile Home ☐ Business ☐ Other

No. Bedrooms 3 No. Bathrooms 2.5 No. Employees


☐ Slab ☑ Crawl Space ☐ Basement w/plumbing ☐ Basement wo/plumbing

Water Supply: ☑ Individual ☐ Community ☐ Public


Comments: Keep trenches shallow - 28" maximum depth. Piping must be shallow from house - Lines must follow slope contour! BEWARE OF WELL ON LOT ACROSS

Comments:

INITIAL SITE SKETCH

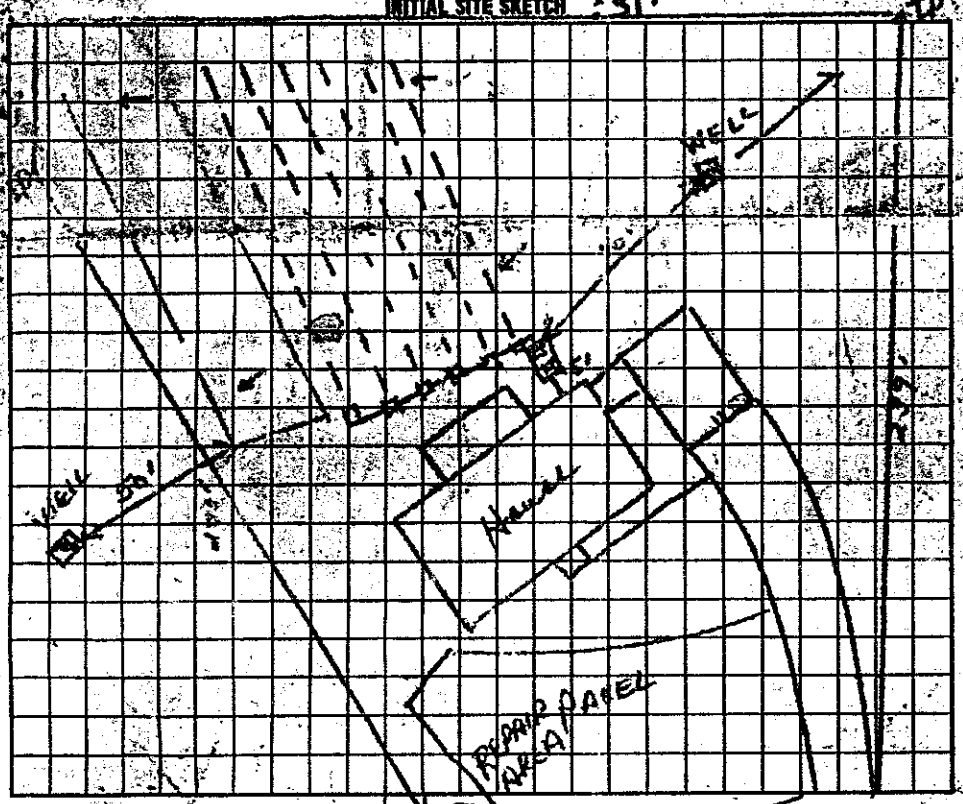

AS BUILT SKETCH

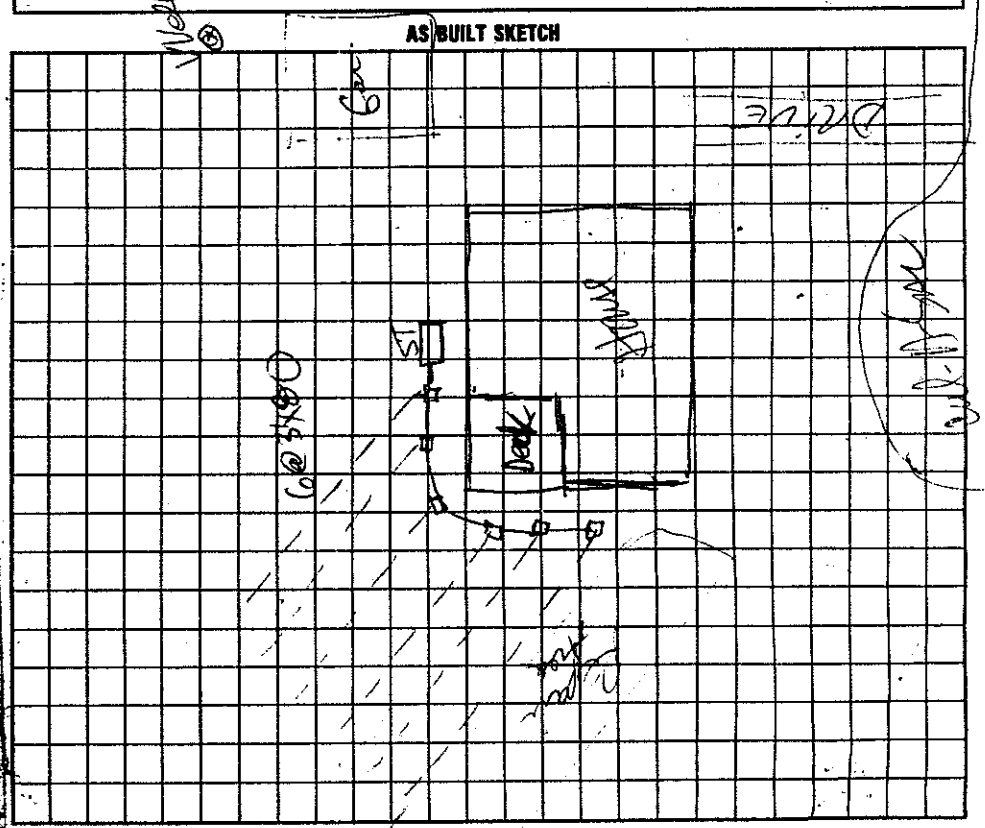

I understand that this permit can be suspended or revoked if any false information is supplied toward securing the permit, any unauthorized changes are made to the site, any unauthorized changes are made in the installation of the system. Improvement Permit is valid for 60 months from date of issuance.

Signed:

Improvement Permit by: Wesley Speer REHS. date 11/1/94

Existing System Inspection by: date

Installed by: Curt Hunsucker

Certificate of Completion by: David C. Hinson REHS date 10/27/94

Operation Permit by: date

HEALTH DEPT. COPY: WHITE INSPECTION COPY (FINAL): GREEN OWNER COPY (FINAL): YELLOW INSPECTION COPY (INITIAL): PINK OWNER COPY (INITIAL): GOLD